

**LOW IMPACT DEVELOPMENT & HYDROLOGY REPORT**  
FOR

514 Prospect Ave.,  
Redondo Beach, CA 90277

Prepared for:  
**City of Redondo Beach**

Prepared by:  
**Labib Funk + Associates**  
**Structural | Shoring | Civil Consulting Engineers**  
319 Main St.  
El Segundo, California 90245  
JLA Job # 22709  
January 25, 2022

## **TABLE OF CONTENTS**

- 1.0 Project Summary
  - 1.1 Existing Conditions
  - 1.2 Proposed Conditions
- 2.0 Low Impact Development
  - 2.1 Methodology
  - 2.2 BMP Feasibility Screening
  - 2.3 BMP Selection

## **Appendices**

- Appendix A – LID Calculations
- Appendix B – BMP Exhibit
- Appendix C – BMP Operation and Maintenance Plan (O&M)
- Appendix D – Soils Report

## **1.0 PROJECT SUMMARY**

### **1.1 Existing Conditions**

The existing project site is located at 514 Prospect Ave., Redondo Beach, California. The existing site is approximately 9.94 acres and consists of three commercial medical buildings, one three story parking garage, one subterranean parking level, asphalt and concrete paving, landscaping, and vacant dirt lot. Storm water runoff from the site sheet flows from East to West along the existing ground contours to Prospect Ave. and towards Towers St.

According to the project geotechnical report (Appendix D) groundwater was not encountered to a depth of 61.5 g, although this level could fluctuate due to local conditions or during rainy seasons.

### **1.2 Proposed Conditions**

The proposed project consists of a multi-level building, parking lot, encircled by a combination of pervious and impervious walks. Storm water runoff from the proposed impervious areas will be collected in area drains and gutters and conveyed through storm drain piping to a system of three infiltration drywells. Storm water on the pervious areas of the site will infiltrate in place or in cases of large storm events be directed to drains to be conveyed to the BMP.

## **2.0 LOW IMPACT DEVELOPMENT (LID)**

### **2.1 Methodology**

The County of Los Angeles Low Impact Development Standards Manual was used to determine the appropriate storm water mitigation solution for the proposed project. For sites subject to low impact development requirements, the City of Redondo Beach defines the storm water quality design volume (SWQDv) as the runoff from a 85<sup>th</sup> percentile 24-hour rain event. The proposed project must retain this volume of runoff onsite or demonstrate that doing so is technically infeasible.

## **2.2 BMP Feasibility Screening**

Due to groundwater depth being greater than 60' from the finished grade and existing soil condition according to the project geotechnical report (Appendix D), infiltration type BMPs will be used on site. The project site will utilize an infiltration drywell to treat the storm water on site and the overflow will be discharged to Prospect Avenue.


## **2.3 BMP Selection**

The proposed infiltration drywell will be installed below grade in a concrete structure which will connect to the overflow sump pump pit. Additionally, a sump pump will convey storm water from the north end of the site to three drywells. Any overflow will be discharged to Prospect Ave. The proposed site incorporates three drywells to treat the site 85<sup>th</sup> percentile storm event.



## **APPENDIX A**

### **LID Calculation**

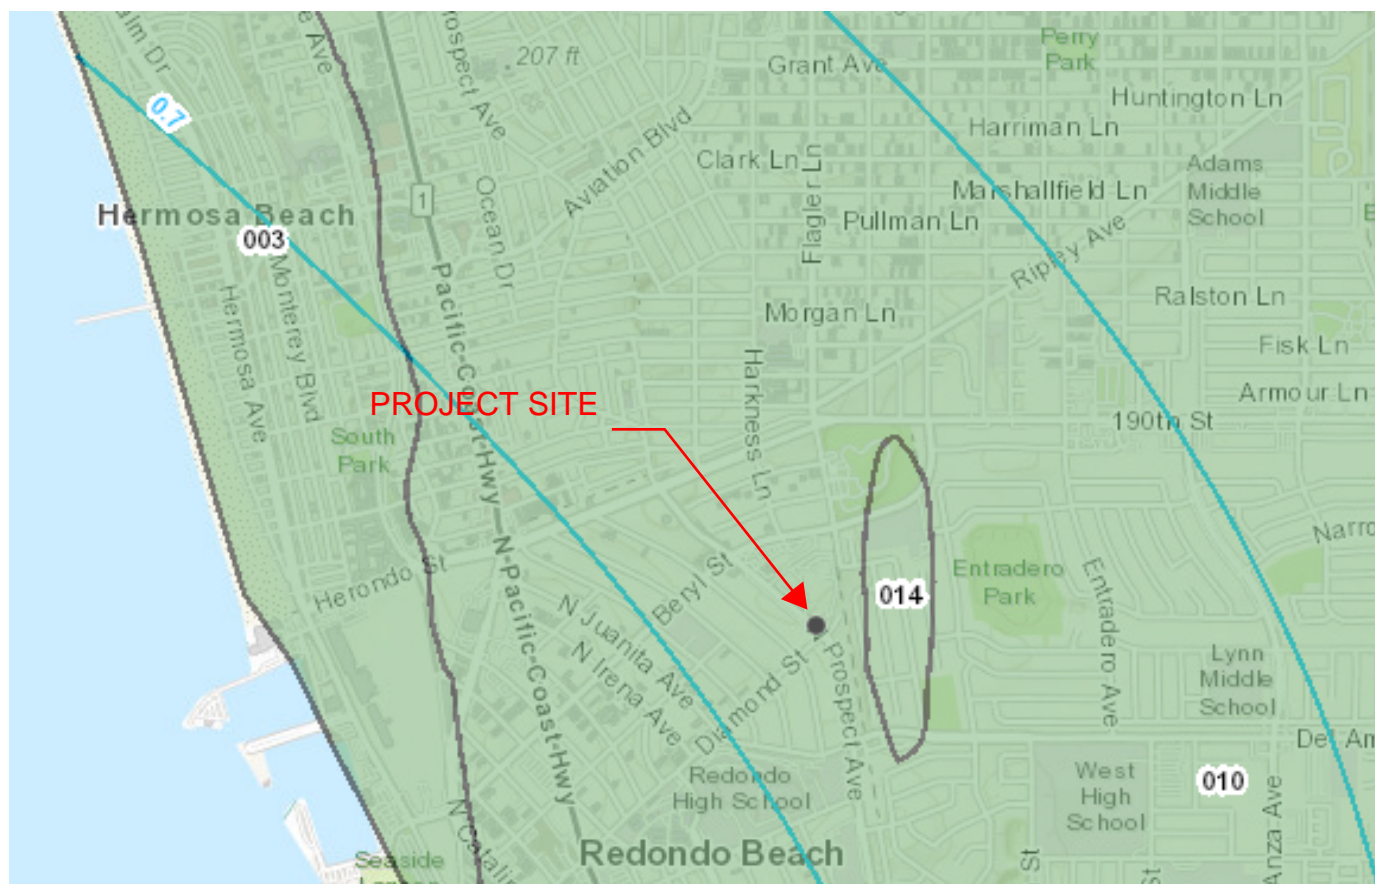

## Legend

### Hydrology GIS

Soils 2004



Final 85th Percentile, 24-hr  
Rainfall



# HydroCalc Volume Analysis

Project: Beach City Health District - Subarea Site \* (Values from project "Peak Flow Hydrologic Analysis")

## HydroCalc Output Results\*

Clear Peak Flow (CFS)	0.4883
24-Hr Clear Runoff Volume (AC-FT)	0.1996
24-Hr Clear Runoff Volume (CF)	8696

## Analysis

### Drywell Disposal Rate (CFS) 0.14226

Total Volume Infiltrated During 1st Phase (CF) 4650.6

[2nd Phase] Storm Flow Rate Exceeds Drywell Disposal Rate @ (MIN) 1033.2

Total Volume Infiltrated During 2nd Phase (CF) 1568.8

[3rd Phase] Drywell Disposal Rate Exceeds Storm Flow Rate @ (MIN) 1217

Total Volume Infiltrated During 3rd Phase (CF) 1139


Total Time of Storm Event (MIN)\* 1490

**Total Volume Infiltrated as it Enters Drywell (CF) 7358**

Total Storage within MaxWell System (CF) 1460

Remaining Detention Required (CF) N/A

Hydrograph: Beach City Health District - Site

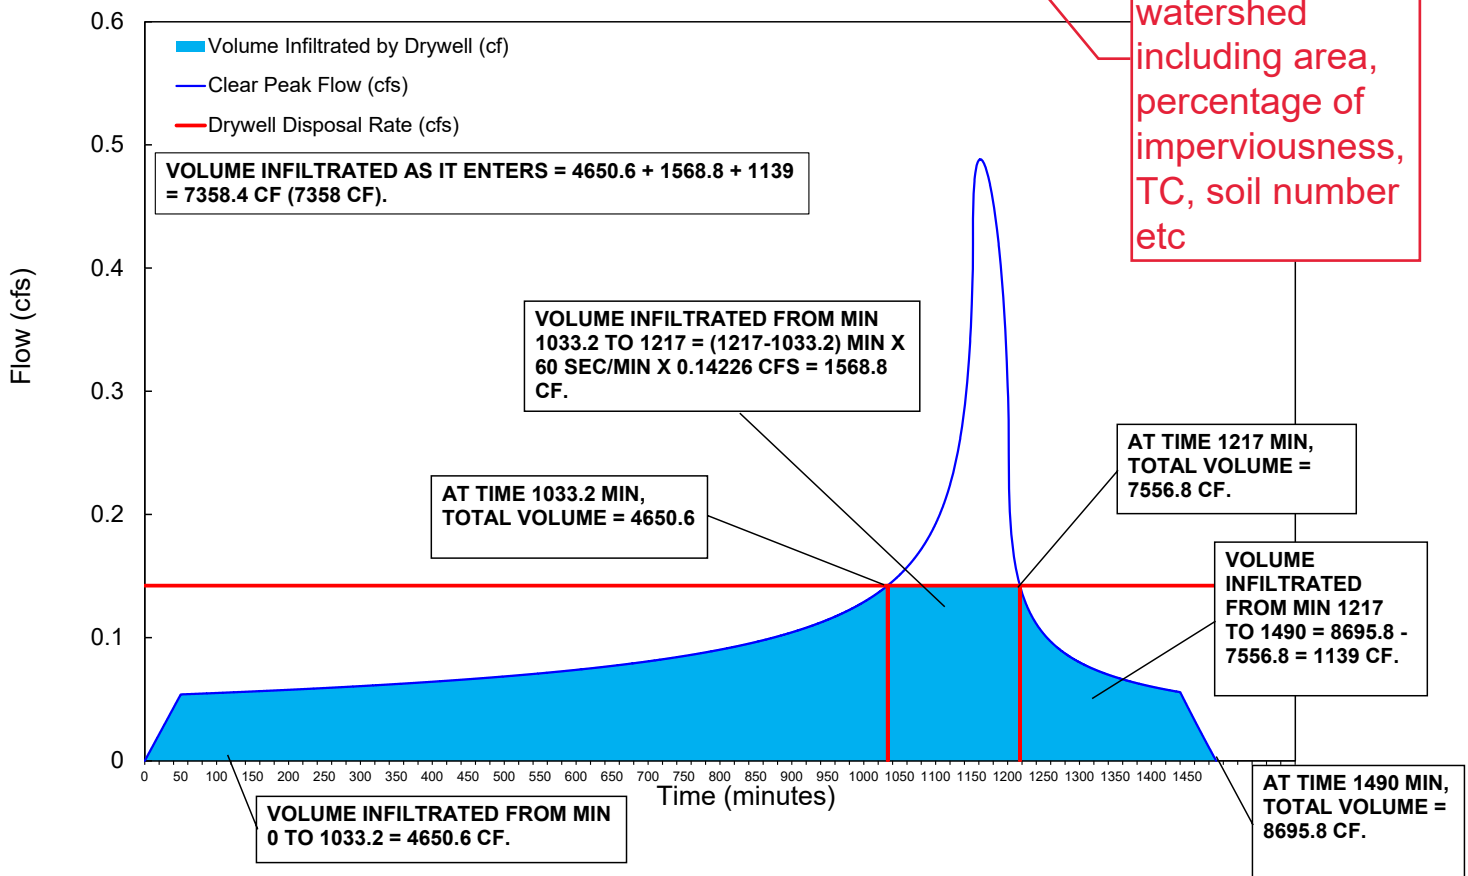

Provide Hydro Calc work sheet for each sub-watershed including area, percentage of imperviousness, TC, soil number etc

**Given:**

Design Infiltration Rate	4.18 in/hr
Mitigated Volume	8,696 ft <sup>3</sup>
Required Drawdown Time	96 hours
Min. Depth to Infiltration	10 ft
Groundwater Depth for Design	61 ft

**Proposed:**

Drywell Rock Shaft Diameter	4 ft
Primary Chamber Depth	19 ft
Drywell Chamber Depth	19 ft
Rock Porosity	40 %
Depth to Infiltration	15 ft
Drywell Bottom Depth	50 ft

Provide details  
about each  
parameter with  
backup  
information

**Convert Design Rate from in/hr to ft/sec.**

$$4.18 \frac{\text{in}}{\text{hr}} \times \frac{1 \text{ ft}}{12 \text{ in}} \times \frac{1 \text{ hr}}{3600 \text{ sec}} = 0.000097 \frac{\text{ft}}{\text{sec}}$$

**A 4 foot diameter drywell provides 12.57 SF of infiltration area per foot of depth, plus 12.57 SF at the bottom.**

**For a 50 foot deep drywell, infiltration occurs between 15 feet and 50 feet below grade. This provides 35 feet of infiltration depth in addition to the bottom area. Infiltration area per drywell is calculated below.**

$$6 \text{ ft} \times 18.85 \frac{\text{ft}^2}{\text{ft}} + 29 \text{ ft} \times 12.57 \frac{\text{ft}^2}{\text{ft}} + 12.57 \text{ ft}^2 = 490 \text{ ft}^2$$

**Combine design rate with infiltration area to get flow (disposal) rate for each drywell.**

$$0.000097 \frac{\text{ft}}{\text{sec}} \times 490 \text{ ft}^2 = 0.04742 \frac{\text{ft}^3}{\text{sec}}$$

**Volume of disposal for each drywell based on various time frames are included below.**

$$96 \text{ hrs: } 0.0474 \text{ CFS} \times 96 \text{ hours} \times \frac{3600 \text{ sec}}{1 \text{ hr}} = 16,389 \text{ cubic feet of retained water disposed of.}$$

**Chamber diameter = 4 feet. Drywell rock shaft diameter = 4 feet.**

**Volume provided in each primary settling chamber with depth of 19 feet.**

$$19 \text{ ft} \times 12.57 \text{ ft}^2 = 239 \text{ ft}^3$$

**Volume provided in each drywell with chamber depth of 19 feet.**

$$19 \text{ ft} \times 12.57 \text{ ft}^2 + 2 \text{ ft} \times 28.27 \text{ ft}^2 \times 40 \% + 29 \text{ ft} \times 12.57 \text{ ft}^2 \times 40 \% = 407 \text{ ft}^3$$

**The MaxWell System is composed of 3 drywell(s) and 1 primary chamber(s).**

$$\text{Total volume provided} = 1460 \text{ ft}^3$$

$$\text{Total 96 hour infiltration volume} = 49,166 \text{ ft}^3$$

$$\text{Total infiltration flowrate} = 0.14226 \frac{\text{ft}^3}{\text{sec}}$$

**Based on the total mitigated volume of 8696 CF, after subtracting the volume infiltrated as quickly as it enters the drywell of 7358 CF, the remaining volume is 1338 CF. The storage provided in the drywell system is 1460 CF.**

**For any questions, please contact Alex Bennett at 213-248-4167 or via email at [Alex.Bennett@Oldcastle.com](mailto:Alex.Bennett@Oldcastle.com)**

## HydroCalc Summary

Provide  
Hydrocalc  
backup  
calculations

Using the hydrograph produced by the HydroCalc Calculator, the area below the drywell hydrograph curve is estimated as the volume infiltrated in the drywell as it enters. 3 different phases are identified for the 85<sup>th</sup> percentile storm event. Phase 1 will occur during the beginning of the storm event produced by the storm. When the storm flow is equal to the drywell flow disposal rate, phase 1 ends and phase 2 begins. Phase 2 is when the drywell performs at the flow rate it was design at. Any additional runoff that is produced due to the increase of storm flow will require a detention system. The storm will then hit its peak flow and begin to decrease. When the storm flow decreases to an amount equal to the drywell flow disposal rate, phase 2 ends and phase 3 begins. Phase 3 will occur near the end the storm when the drywell infiltrates the residual runoff until the end of the event.

### Phase 1 – Initial Filling of Drywell

From time 0 minutes to 1033.2 minutes, the 85th storm event flowrate that enters the drywell is less than the drywell steady-state infiltration flowrate (flow disposal rate). Therefore, the entire volume entering the drywell from 0 minutes to 1033.2 minutes will infiltrate without overwhelming the drywell. This volume is 4650.6 CF.

Time (min)	Incremental Masscurve	Incremental Design Storm Depth (in)	Intensity (in/hr)	Undeveloped Runoff Coefficient (Cu)	Developed Runoff Coefficient (Cd)	Clear Peak Flow Rate (cfs)	Incremental Volume (cu-ft)	Cumulative Volume (cu-ft)	Volume infiltrated by drywell (CF)
1033	0.559807157	0.419855368	0.044167482	0.1	0.324	0.142244	1.706363348	4648.877508	1.706363348
1033.2	0.560021195	0.420015896	0.044196779	0.1	0.324	0.1423384	1.707494428	4650.585003	1.70712
1033.4	0.560235402	0.420176552	0.044226139	0.1	0.324	0.1424329	1.70862788	4652.293631	1.70712

### Phase 2 – Drywell Performing at the Design Rate

From time 1033.2 minutes to 1217 minutes, the flowrate that enters the drywell exceeds the drywell steady-state infiltration flowrate (flow disposal rate). Therefore, the drywell can only infiltrate up to its flow disposal rate which is 0.14226 CFS. Over this period, we multiply the time by the flowrate (and covert as needed) to determine the volume infiltrated in this phase. This volume is 1568.8 CF.

$$(1217-1033.2) \times 60 \text{ SEC/MIN} \times 0.14226 \text{ CFS} = 1568.8 \text{ CF}$$

Time (min)	Incremental Masscurve	Incremental Design Storm Depth (in)	Intensity (in/hr)	Undeveloped Runoff Coefficient (Cu)	Developed Runoff Coefficient (Cd)	Clear Peak Flow Rate (cfs)	Incremental Volume (cu-ft)	Cumulative Volume (cu-ft)	Volume infiltrated by drywell (CF)
1216.8	0.890716593	0.668037445	0.044317065	0.1	0.324	0.1427258	1.715309165	7555.100421	1.70712
1217	0.89086488	0.66814866	0.044184018	0.1	0.324	0.1422973	1.710138282	7556.810559	1.70712
1217.2	0.891012952	0.668259714	0.044052444	0.1	0.324	0.1418735	1.705024915	7558.515584	1.705024915

### Phase 3 – End of the Storm Event

From time 1217 to 1490 minute (end of storm event), the 85th storm event flowrate that enters the drywell is less than the drywell steady-state infiltration flowrate (flow disposal rate). Therefore, the entire volume entering the drywell from 1217 minutes to 1490 minutes will infiltrate without overwhelming the drywell. This volume is 1139 CF.


$$8695.8 \text{ CF} - 7556.8 \text{ CF} = 1139 \text{ CF}$$

Time (min)	Incremental Masscurve	Incremental Design Storm Depth (in)	Intensity (in/hr)	Undeveloped Runoff Coefficient (Cu)	Developed Runoff Coefficient (Cd)	Clear Peak Flow Rate (cfs)	Incremental Volume (cu-ft)	Cumulative Volume (cu-ft)	Volume infiltrated by drywell (CF)
1489.8	1	0.75	6.62608E-05	0.1	0.324	0.0002134	0.003841563	8695.791709	0.003841563
1490	1	0.75	0	0.1	0.324	0	0.001280382	8695.79299	0.001280382
	0	0	0	0	0	0	0	0	0

The total volume infiltrated as it enters the drywell during the 85th percentile storm event is 4650.6 + 1568.8 + 1139 = 7358.3 CF (7358 CF)

**APPENDIX B**  
**BMP Exhibit**



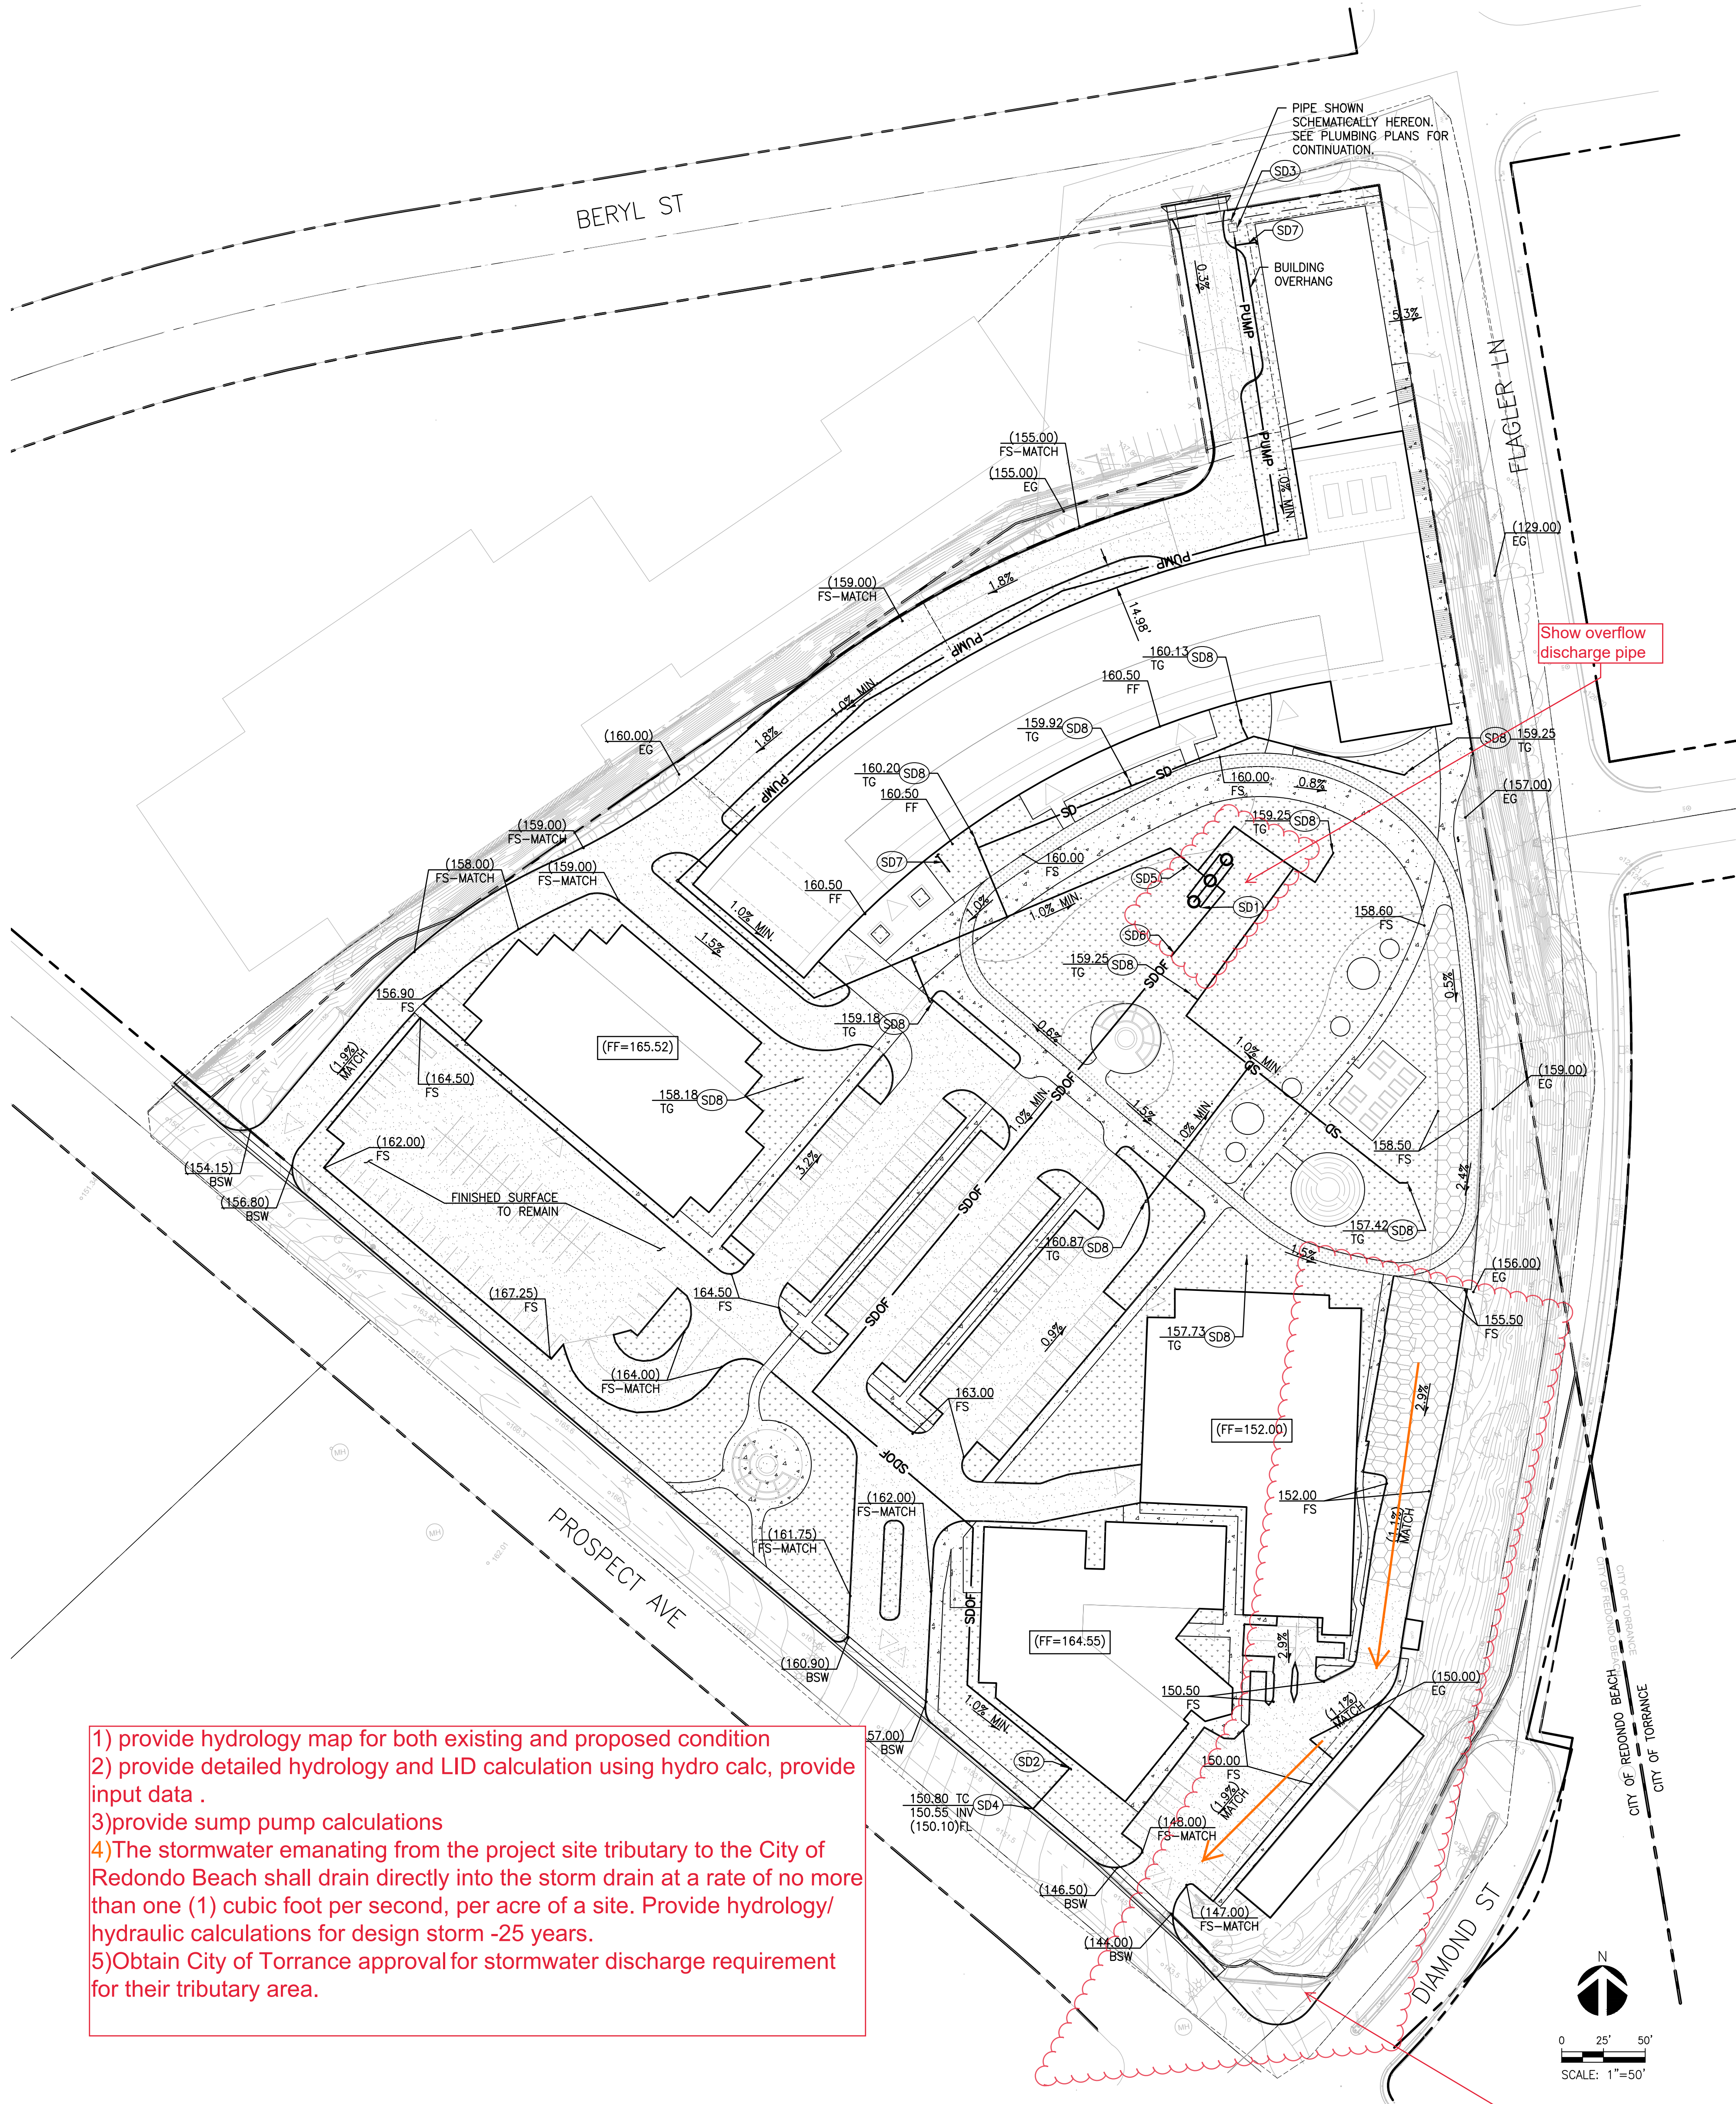

- 1) provide hydrology map for both existing and proposed condition
- 2) provide detailed hydrology and LID calculation using hydro calc, provide input data .
- 3) provide sump pump calculations
- 4) The stormwater emanating from the project site tributary to the City of Redondo Beach shall drain directly into the storm drain at a rate of no more than one (1) cubic foot per second, per acre of a site. Provide hydrology/ hydraulic calculations for design storm -25 years.
- 5) Obtain City of Torrance approval for stormwater discharge requirement for their tributary area.

Flow shall be routed to BMP

### LEGEND

- LANDSCAPE BY OTHERS.
- CONCRETE PAVING.
- ASPHALT PAVING. DEPTH OF ASPHALT AND BASE TO MATCH EXISTING.
- COMPACTED DG PER LANDSCAPE PLANS.
- GRASSCRETE.

PROJECT SITE CHARACTERISTICS	
	QUANTITIES
TOTAL SITE AREA (S.F.)	433,194
PROPOSED BUILDING FOOTPRINT(S.F)	46,807
EXISTING BUILDING FOOTPRINT(S.F)	57,336
PROPOSED HARDSCAPE(S.F)	183,954
EXISTING HARDSCAPE TO REMAIN(S.F)	27,947
IMPERVIOUS %	72%
LANDSCAPE	109,097
GRASSCRETE	11,053
TOTAL PERVIOUS AREA (S.F.)	120,150
RAINFALL INTENSITY (IN/HR)	0.75
DCV(cf)	8,696


### CONSTRUCTION NOTES

#### STORM DRAIN

- (SD1) INSTALL DRYWELL PER DETAIL 1, HEREON.
- (SD2) STORM DRAIN OVERFLOW POINT OF CONNECTION.
- (SD3) SUMP PUMP PER OTHERS. SHOWN SCHEMATICALLY HEREON.
- (SD4) INSTALL CURB DRAIN APWA STD. PLAN 151-4.
- (SD5) PVC STORM DRAIN CONVEYANCE PIPING.
- (SD6) PVC OVERFLOW PIPE.
- (SD7) STORM DRAIN POINT OF CONNECTION. SEE PLUMBING PLANS FOR CONTINUATION FROM ROOF DRAINS.
- (SD8) 6" AREA DRAIN BY NDS PRO OR APPROVED EQUAL.

#### NOTES

1. ALL DOWNSPOUTS TO DRAIN TO PROPOSED BMPS. SEE PLUMBING PLANS.
2. INSTALL STENCIL EPR DETAIL AT ALL APPLICABLE LOCATIONS

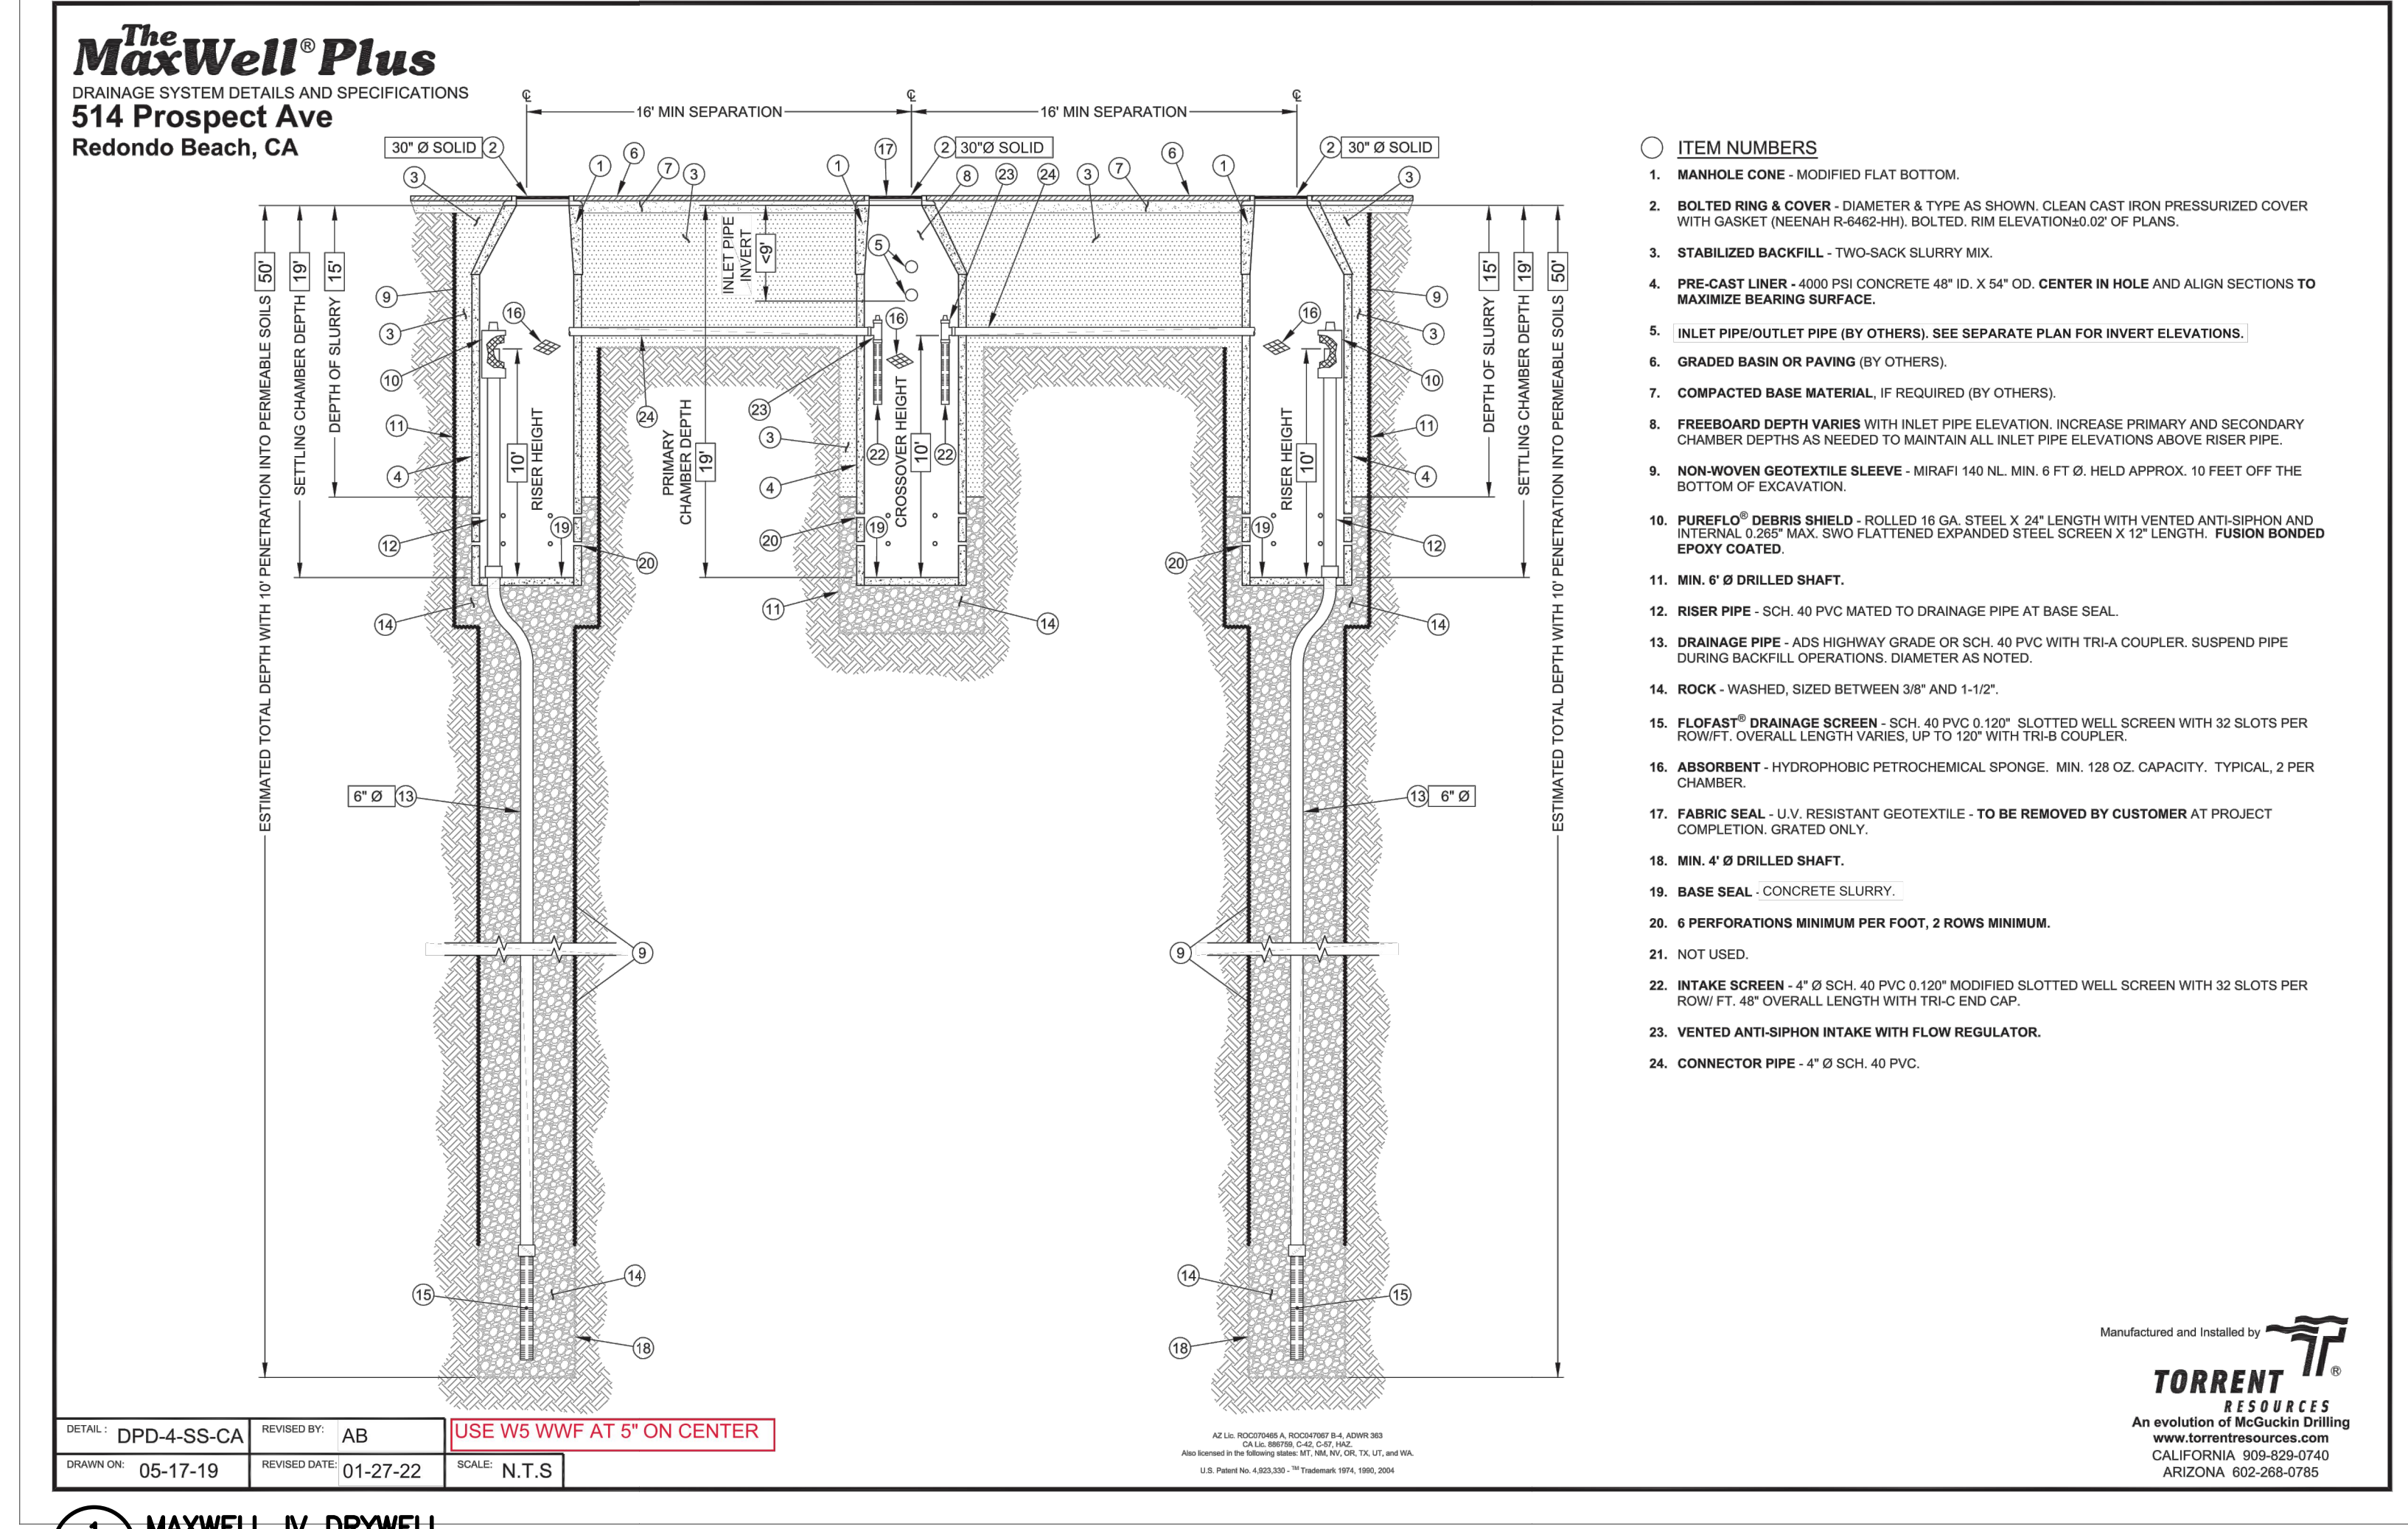

MaxWell® Plus Drainage System Calculations Prepared on January 27, 2022  
Project: Beach City Health District - Redondo Beach, CA  
Contact: Connor Crowley at Labib Funk + Associates - Los Angeles, CA

<b>Given:</b>	
Design Infiltration Rate	4.18 in/hr
Mitigated Volume	8,696 ft <sup>3</sup>
Required Drawdown Time	96 hours
Min. Depth to Infiltration	10 ft
Groundwater Depth for Design	61 ft
<b>Proposed:</b>	
Drywell Rock Shaft Diameter	4 ft
Primary Chamber Depth	19 ft
Drywell Chamber Depth	19 ft
Rock Porosity	40 %
Depth to Infiltration	15 ft
Drywell Bottom Depth	50 ft

Convert Design Rate from in/hr to ft/sec.  
 $4.18 \frac{\text{in}}{\text{hr}} \times \frac{1 \text{ ft}}{12 \text{ in}} \times \frac{1 \text{ hr}}{3600 \text{ sec}} = 0.000097 \frac{\text{ft}}{\text{sec}}$

A 4 foot diameter drywell provides 12.57 SF of infiltration area per foot of depth, plus 12.57 SF at the bottom.

For a 50 foot deep drywell, infiltration occurs between 15 feet and 50 feet below grade. This provides 35 feet of infiltration depth in addition to the bottom area. Infiltration area per drywell is calculated below.

$$6 \text{ ft} \times 18.85 \frac{\text{ft}^2}{\text{ft}} + 29 \text{ ft} \times 12.57 \frac{\text{ft}^2}{\text{ft}} + 12.57 \text{ ft}^2 = 490 \text{ ft}^2$$

Combine design rate with infiltration area to get flow (disposal) rate for each drywell.  
 $0.000097 \frac{\text{ft}}{\text{sec}} \times 490 \text{ ft}^2 = 0.04742 \frac{\text{ft}^3}{\text{sec}}$

Volume of disposal for each drywell based on various time frames are included below.

96 hrs:  $0.0474 \text{ CFS} \times 96 \text{ hours} \times \frac{2000 \text{ gal}}{\text{ft}^3} = 16,389 \text{ cubic feet of retained water disposed of.}$

Chamber diameter = 4 feet. Drywell rock shaft diameter = 4 feet.

Volume provided in each primary settling chamber with depth of 19 feet.

$$19 \text{ ft} \times 12.57 \text{ ft}^2 = 239 \text{ ft}^3$$

Volume provided in each drywell with chamber depth of 19 feet.

$$19 \text{ ft} \times 12.57 \text{ ft}^2 + 2 \text{ ft} \times 28.27 \text{ ft}^2 \times 40 \% + 29 \text{ ft} \times 12.57 \text{ ft}^2 \times 40 \% = 407 \text{ ft}^3$$

The MaxWell System is composed of 3 drywell(s) and 1 primary chamber(s).

Total volume provided = 1460 ft<sup>3</sup>

Total 96 hour infiltration volume = 49,166 ft<sup>3</sup>


Total infiltration flowrate = 0.14226  $\frac{\text{ft}^3}{\text{sec}}$

Based on the total mitigated volume of 8696 CF, after subtracting the volume infiltrated as quickly as it enters the drywell of 7358 CF, the remaining volume is 1338 CF. The storage provided in the drywell system is 1460 CF.

For any questions, please contact Alex Bennett at 213-248-4167 or via email at Alex.Bennett@Oldcastle.com



Torrent Resources (CA) Incorporated  
9950 Alder Avenue  
Bloomington, CA 92316  
Phone 907-627-0740

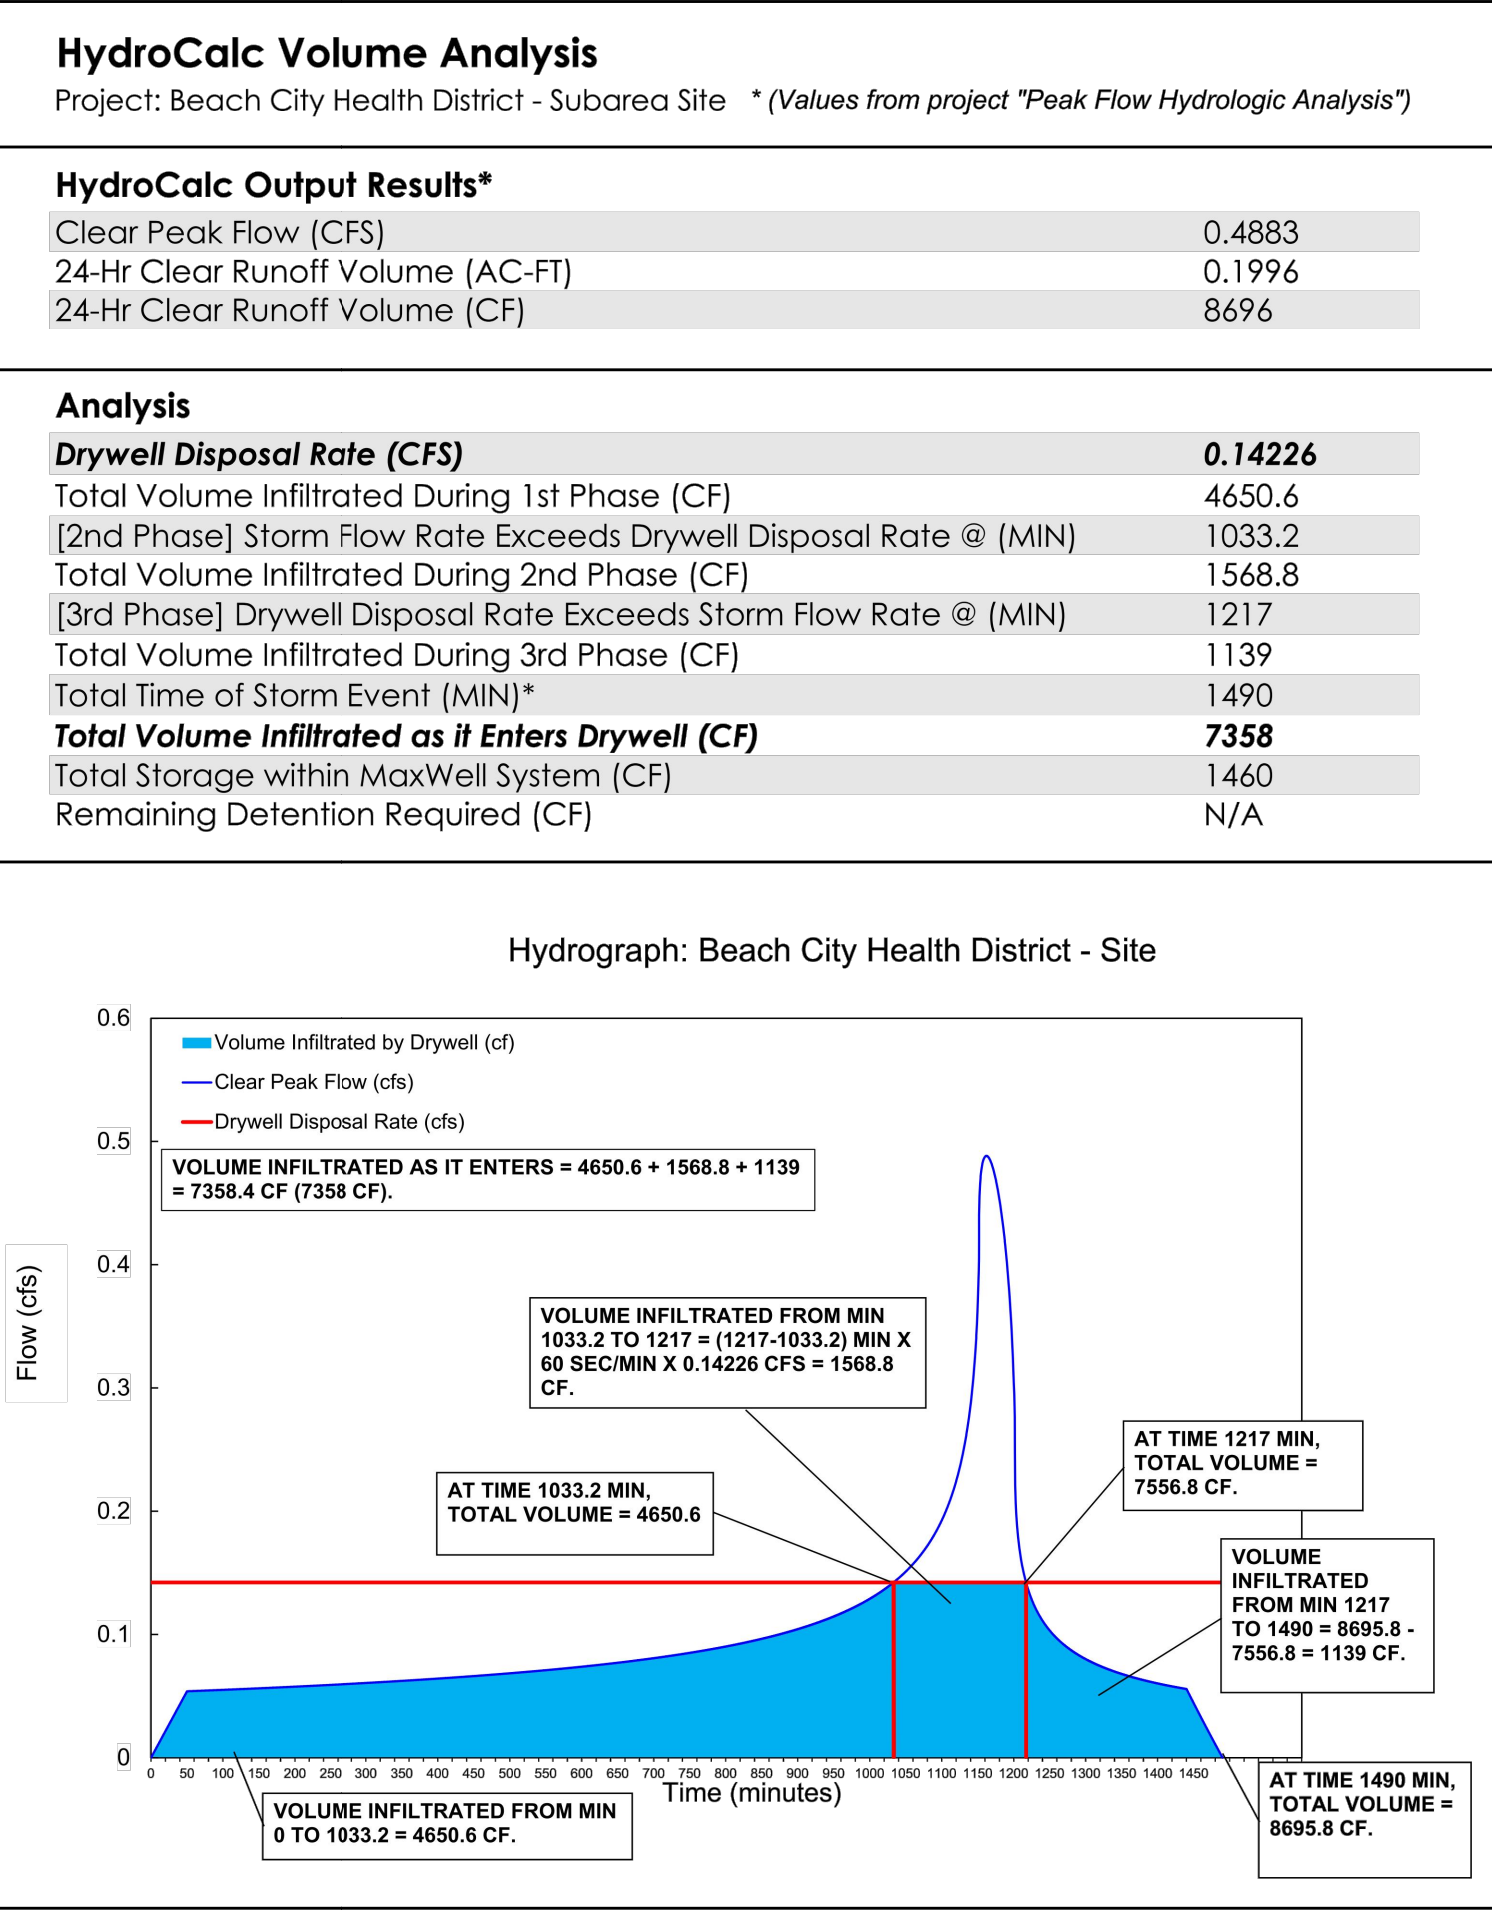

PAUL MURDOCH  
ARCHITECTS

8820 Wilshire Blvd, Suite 330  
Beverly Hills, California 90211  
310 358-0993 F.310 358-9196

THE DRAWINGS AND SPECIFICATIONS AND IDEAS, DESIGNS, AND ARRANGEMENTS REPRESENTED HEREBY ARE AND SHALL REMAIN THE PROPERTY OF THE ARCHITECT, AND NO PART THEREOF SHALL BE COPIED, DISCLOSED TO OTHERS, OR USED IN CONNECTION WITH ANY WORK OR PROJECT OTHER THAN THE SPECIFIC PROJECT FOR WHICH THEY HAVE BEEN PREPARED AND DELIVERED WITHOUT THE WRITTEN CONSENT OF THE ARCHITECT. VISUAL CONTACT WITH THESE DRAWINGS OR SPECIFICATIONS SHALL CONSTITUTE CONCLUSIVE EVIDENCE OF ACCEPTANCE OF THESE RESTRICTIONS. WRITTEN DIMENSIONS ON THESE DRAWINGS SHALL HAVE PRECEDENCE OVER SCALED DIMENSIONS. CONTRACTORS SHALL VERIFY AND BE RESPONSIBLE FOR ALL DIMENSIONS AND CONDITIONS ON THE JOB AND THIS OFFICE MUST BE NOTIFIED OF ANY VARIATIONS FROM THE DIMENSIONS AND CONDITIONS SHOWN BY THESE DRAWINGS. SHOP DETAILS MUST BE SUBMITTED TO THIS OFFICE FOR REVIEW BEFORE PROCEEDING WITH FABRICATION.



319 Main Street  
El Segundo, CA 90245  
Tel: 213.239.9700

JLA Job No. 19725



NO. DATE REVISION

BEACH CITIES  
HEALTH DISTRICT  
HEALTHY LIVING  
CAMPUS

514 NORTH PROSPECT AVE.  
REDONDO BEACH, CA 90277

PMA PROJECT NO.  
19010

DRAWING TITLE  
LOW IMPACT  
DEVELOPMENT  
PLAN

SCALE  
AS NOTED

DATE  
01/06/20

DRAWN CHECKED  
Author Checker

SHEET NO.

C-300