

PLUMBING PLOT PLAN
SOUTH BAY HOSPITAL DISTRICT
REDONDO BEACH, CALIFORNIA

TO BE ADJUSTED TO
FIELD CONDITIONS
BY THE CONTRACTOR
AS NECESSARY
FOR PROPER
INSTALLATION
OF THE PLUMBING
SYSTEM


PLUMBING PLOT PLAN
SOUTH BAY HOSPITAL DISTRICT
REDONDO BEACH, CALIFORNIA

PLUMBING PLOT PLAN
SOUTH BAY HOSPITAL DISTRICT
REDONDO BEACH, CALIFORNIA

WALKER & K
A
LOS
AUG
HOS

HENRY M. LAYNE
STRUCTURAL ENGINEER
SAMUEL L. KAYE
MECHANICAL ENGINEER
FOSTER K. SANDERSON
ELECTRICAL ENGINEER


REVISIONS

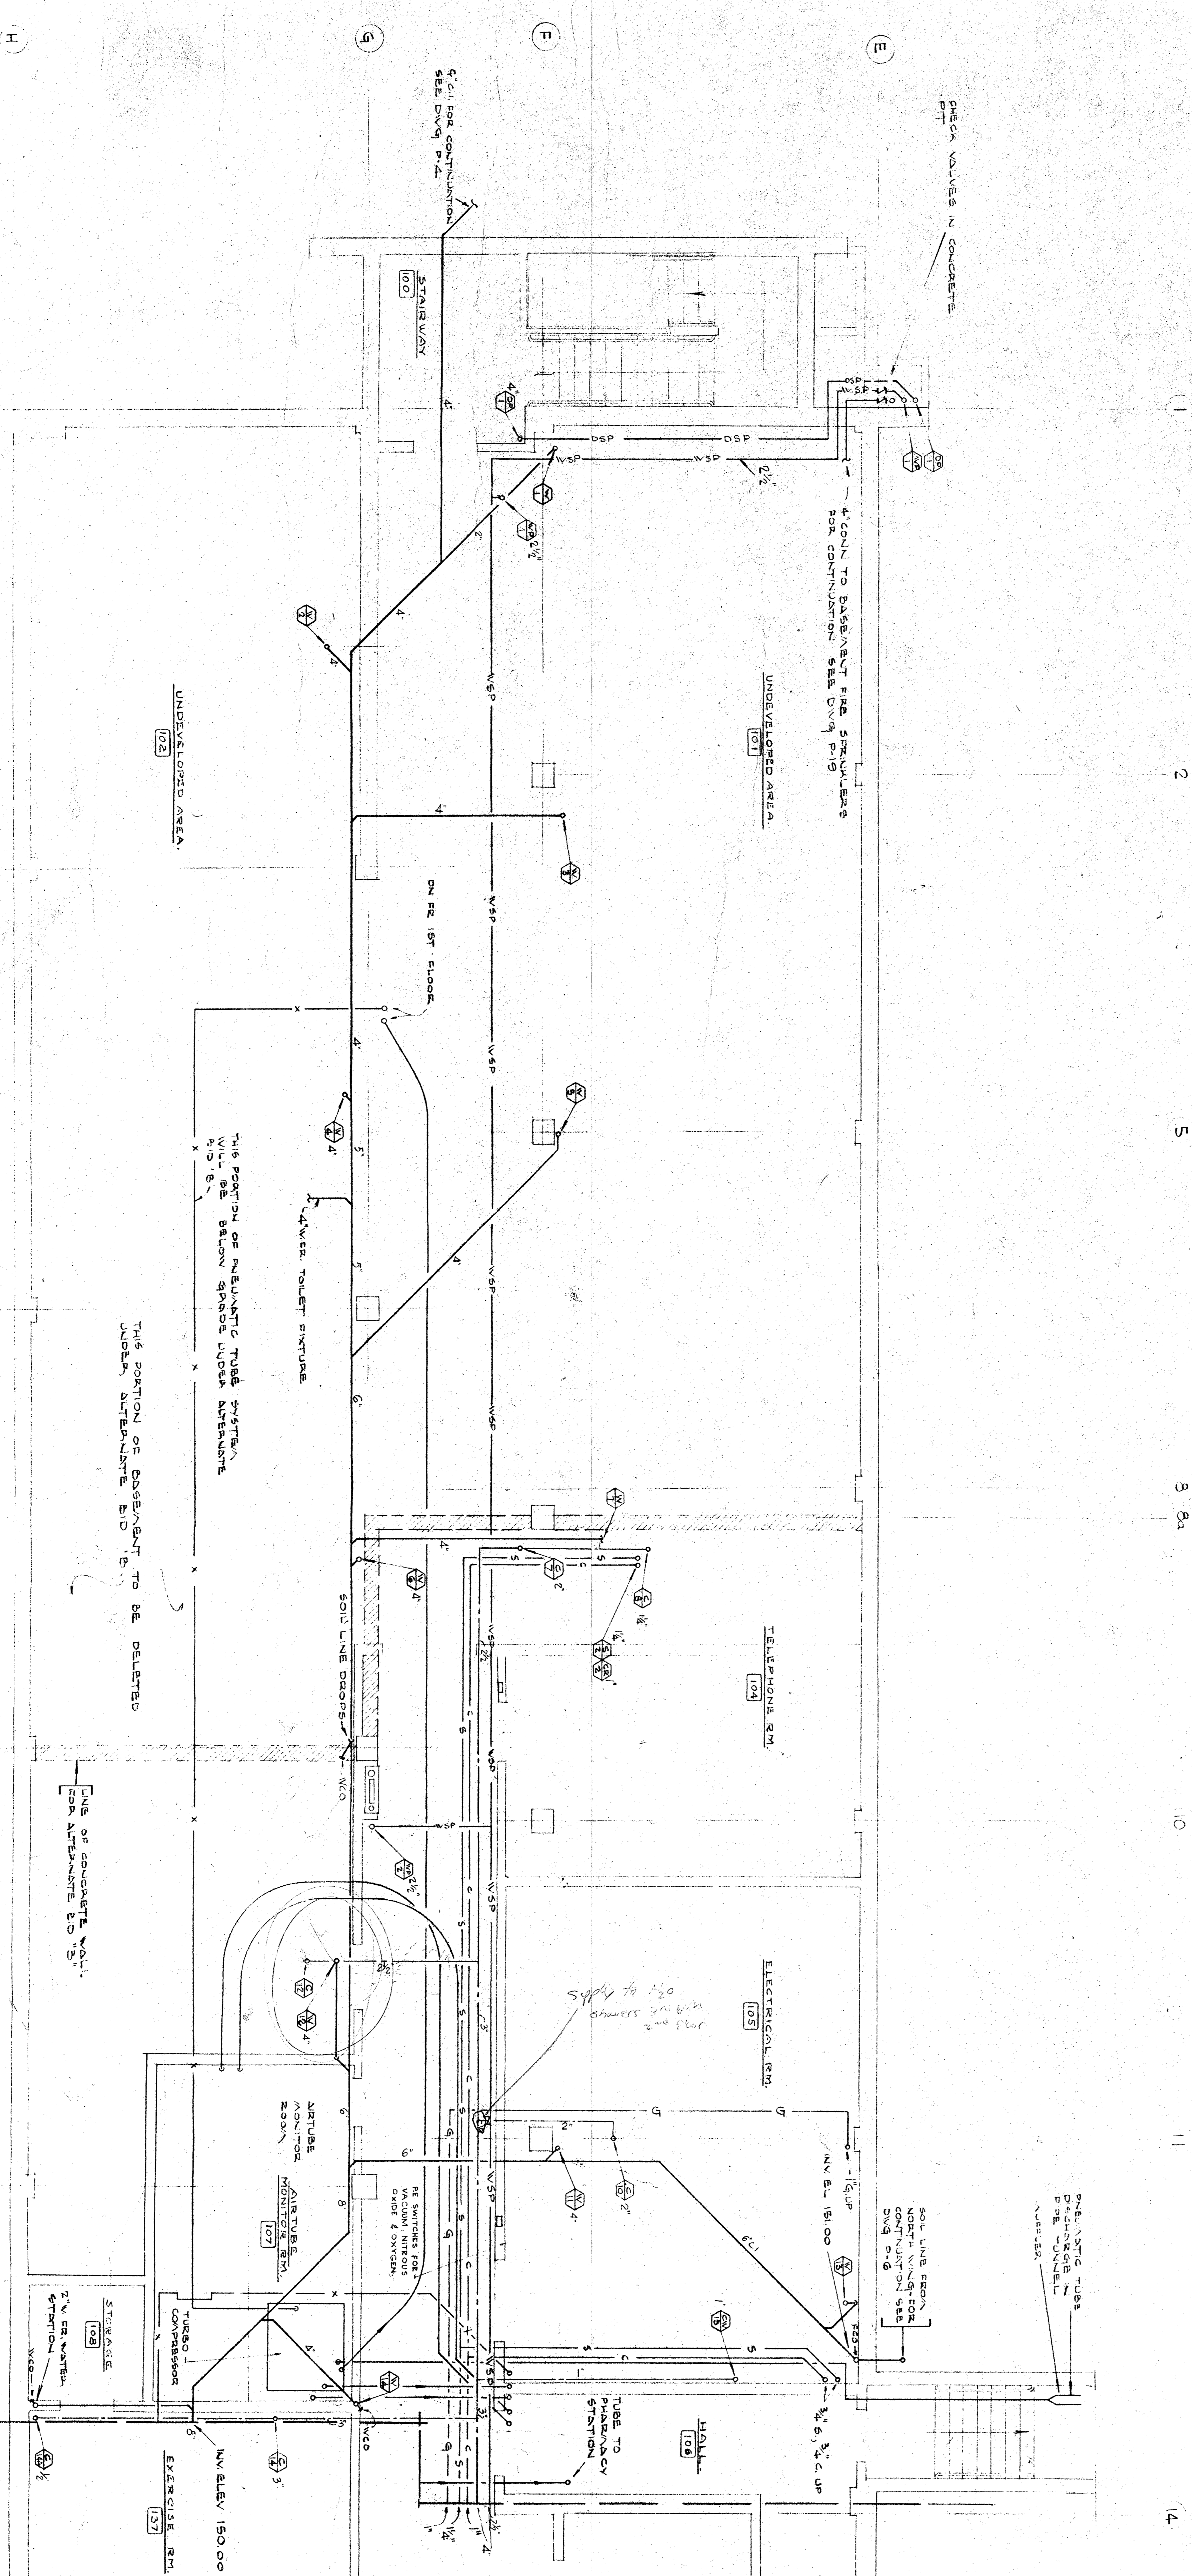

PLUMBING BASEMENT - WEST.		WALKER • KALIONZES • KLINGERMANN		HENRY M. LAYNE	
SOUTH BAY HOSPITAL		ARCHITECTS		STRUCTURAL ENGINEER	
SOUTH BAY HOSPITAL DISTRICT		LOS ANGELES, CALIFORNIA		SAMUEL L. KAYE	
REDONDO BEACH, CALIFORNIA		AUGUST W. KOENIG		MECHANICAL ENGINEER	
		HOSPITAL CONSULTANT		FOSTER K. SAMPSON	
				ELECTRICAL ENGINEER	
				REVISIONS	

DETAIL OF STEAM & CONDENSATE PIPING
IN TRANSITE PIPE BELOW GRADE
NO SCALE

LAUNDRY SAND INTERCEPTOR
7'-0" x 4'-0" INSIDE DIM
NO SCALE

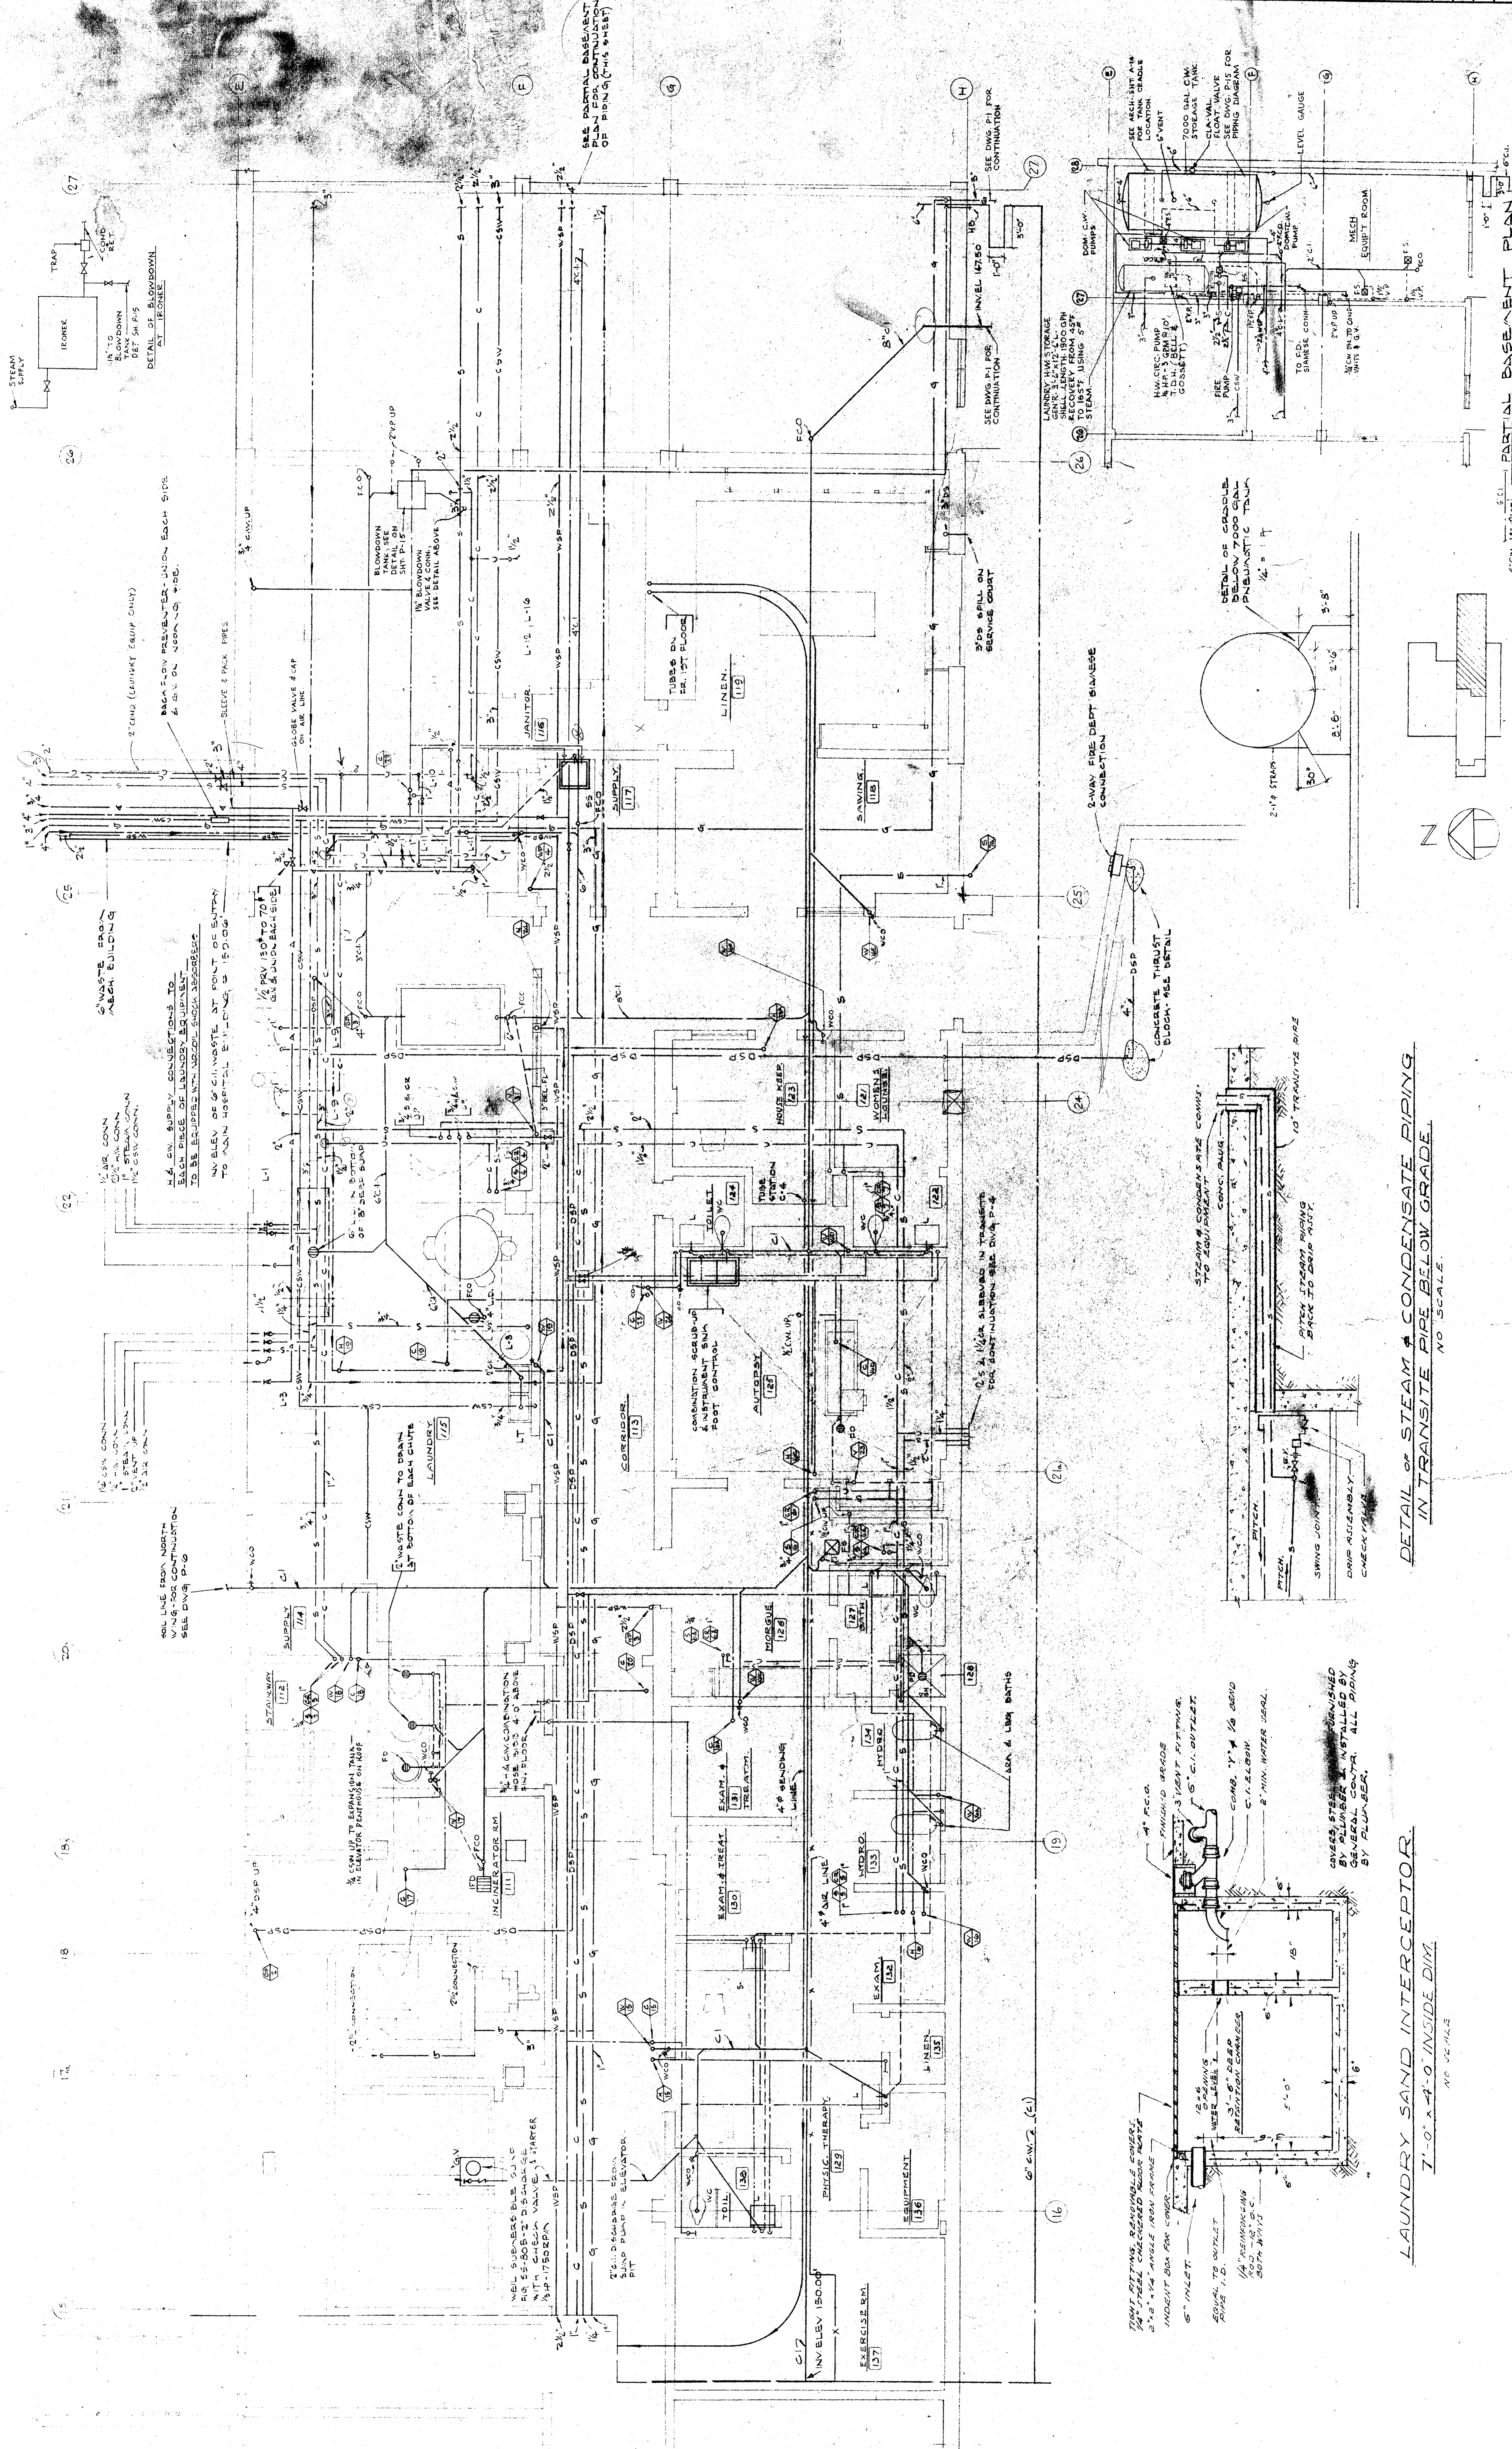


CHECKED
DATE 12-16-57

PLUMBING - FIRST FLOOR - WEST
SOUTH BAY HOSPITAL
REDONDO BEACH, CALIFORNIA

WALKER • KALONZES • KLINGERMAN
AUGUST W. KOENIG
HOSPITAL CONSULTANT
LOS ANGELES, CALIFORNIA

HENRY M. LAYNE
STRUCTURAL ENGINEER
SAMUEL L. KAYE
MECHANICAL ENGINEER
FOSTER K. SAMSON
ELECTRICAL ENGINEER


REVISIONS

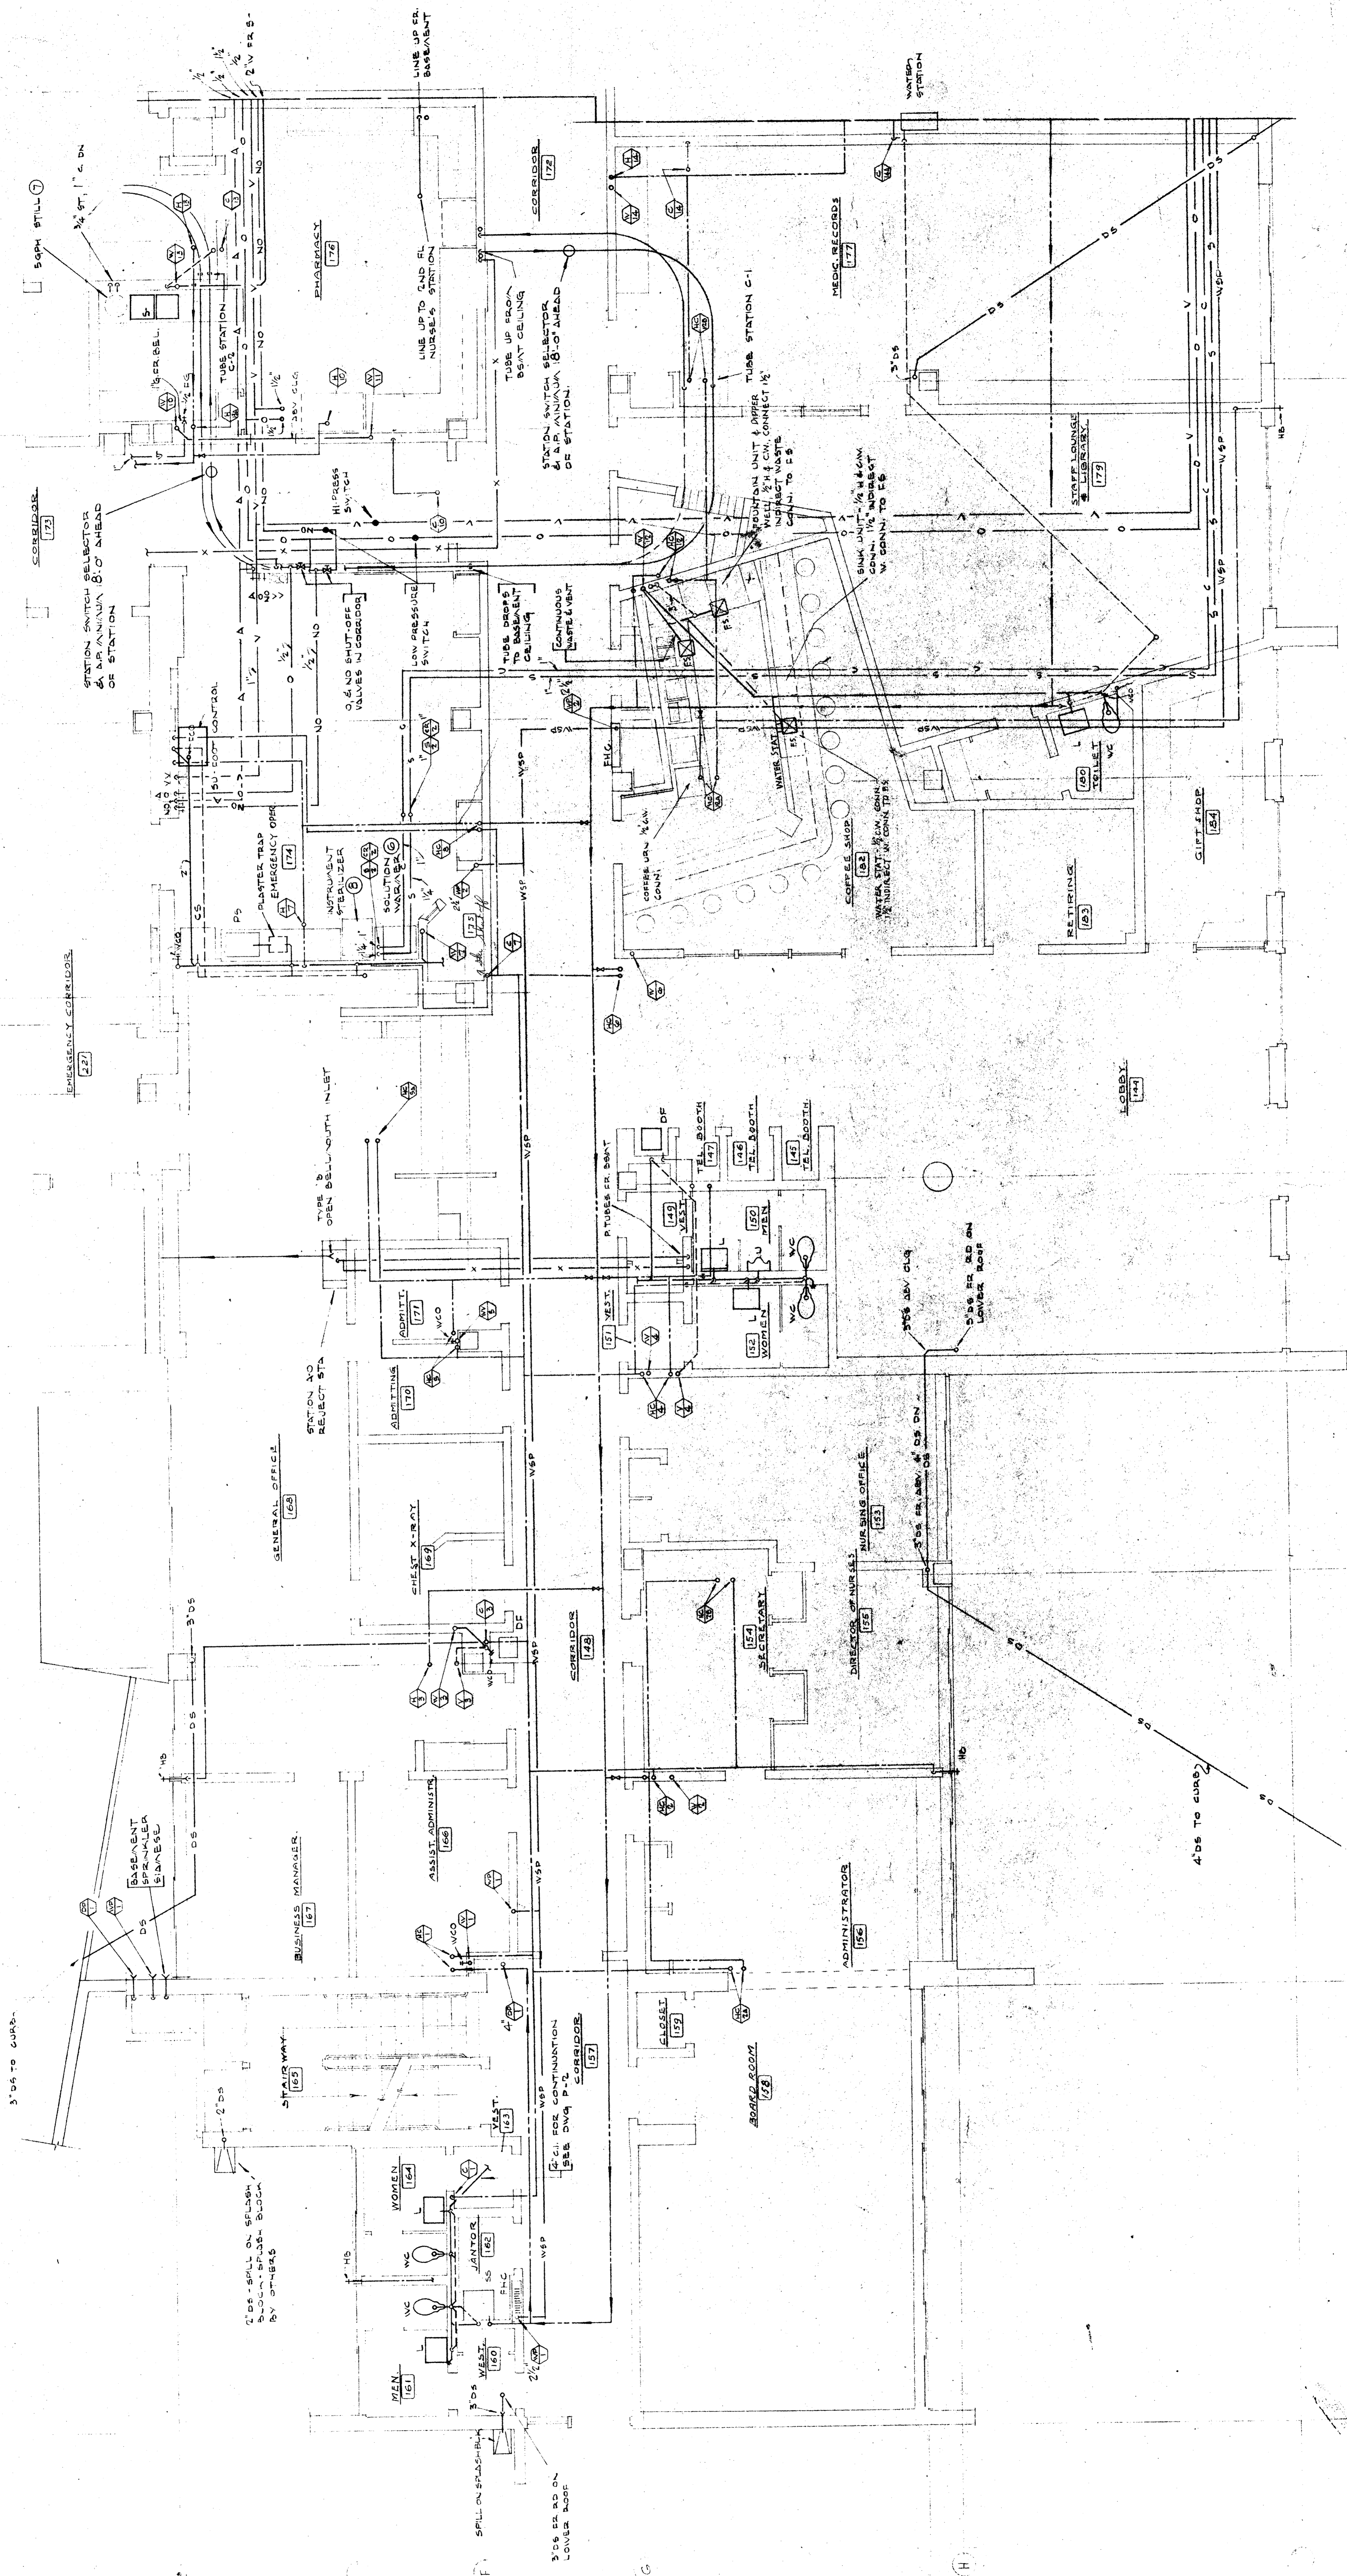

DRY STAND PIPE

DP
3

27

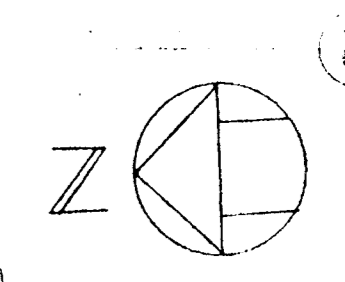

KEY PLAN


26

25

24

21

9

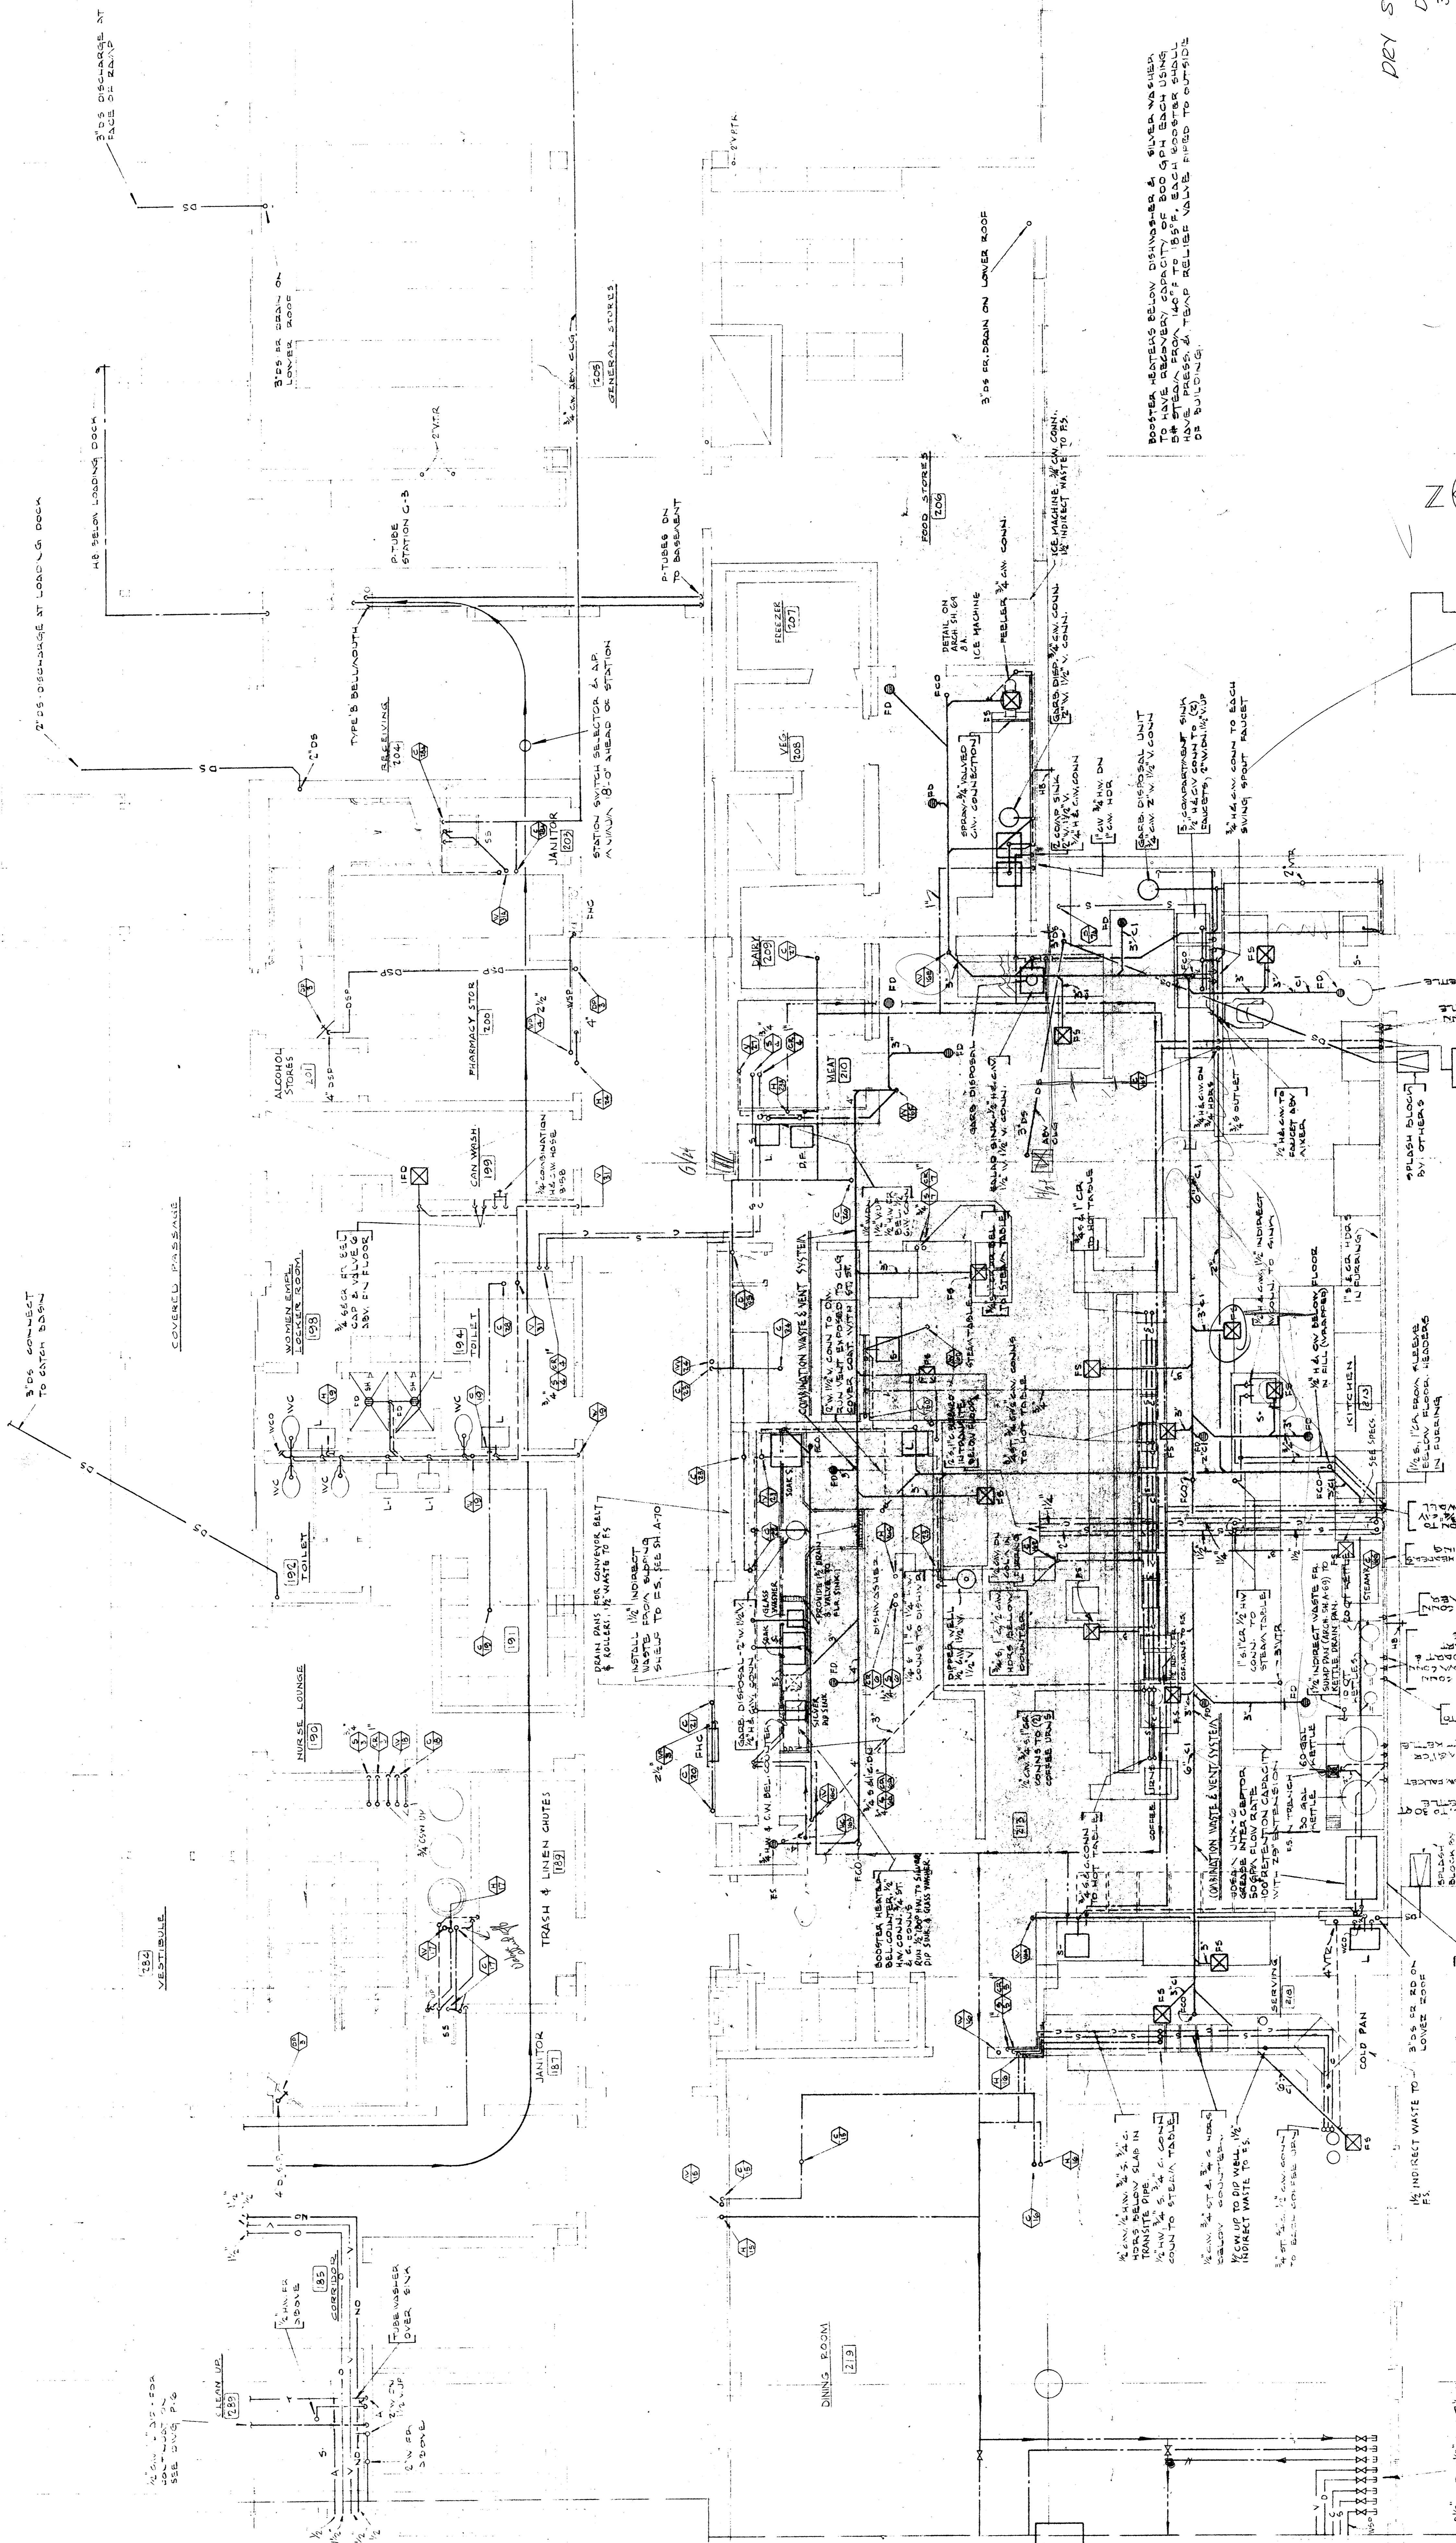

REQUIRED 2\"/>

TO HAVE CAPACITY OF 800 GPH EACH USING
5\"/>

3\"/>

ICE MACHINE 1/2\"/>

DETAIL ON
ICE MACHINE

3\"/>



















2\"/>

2\"/>

3\"/>


























P-3 FOR
D.S.P.



KEY PLAN

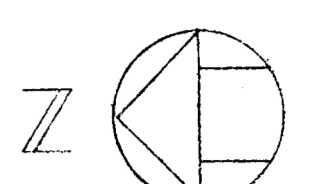


FOR CONTINUATION
SEE DWG P-5


NOTE: RUN ALL VAPOR VENTS ON STERILIZERS
SEPARATELY THRU ROOF.


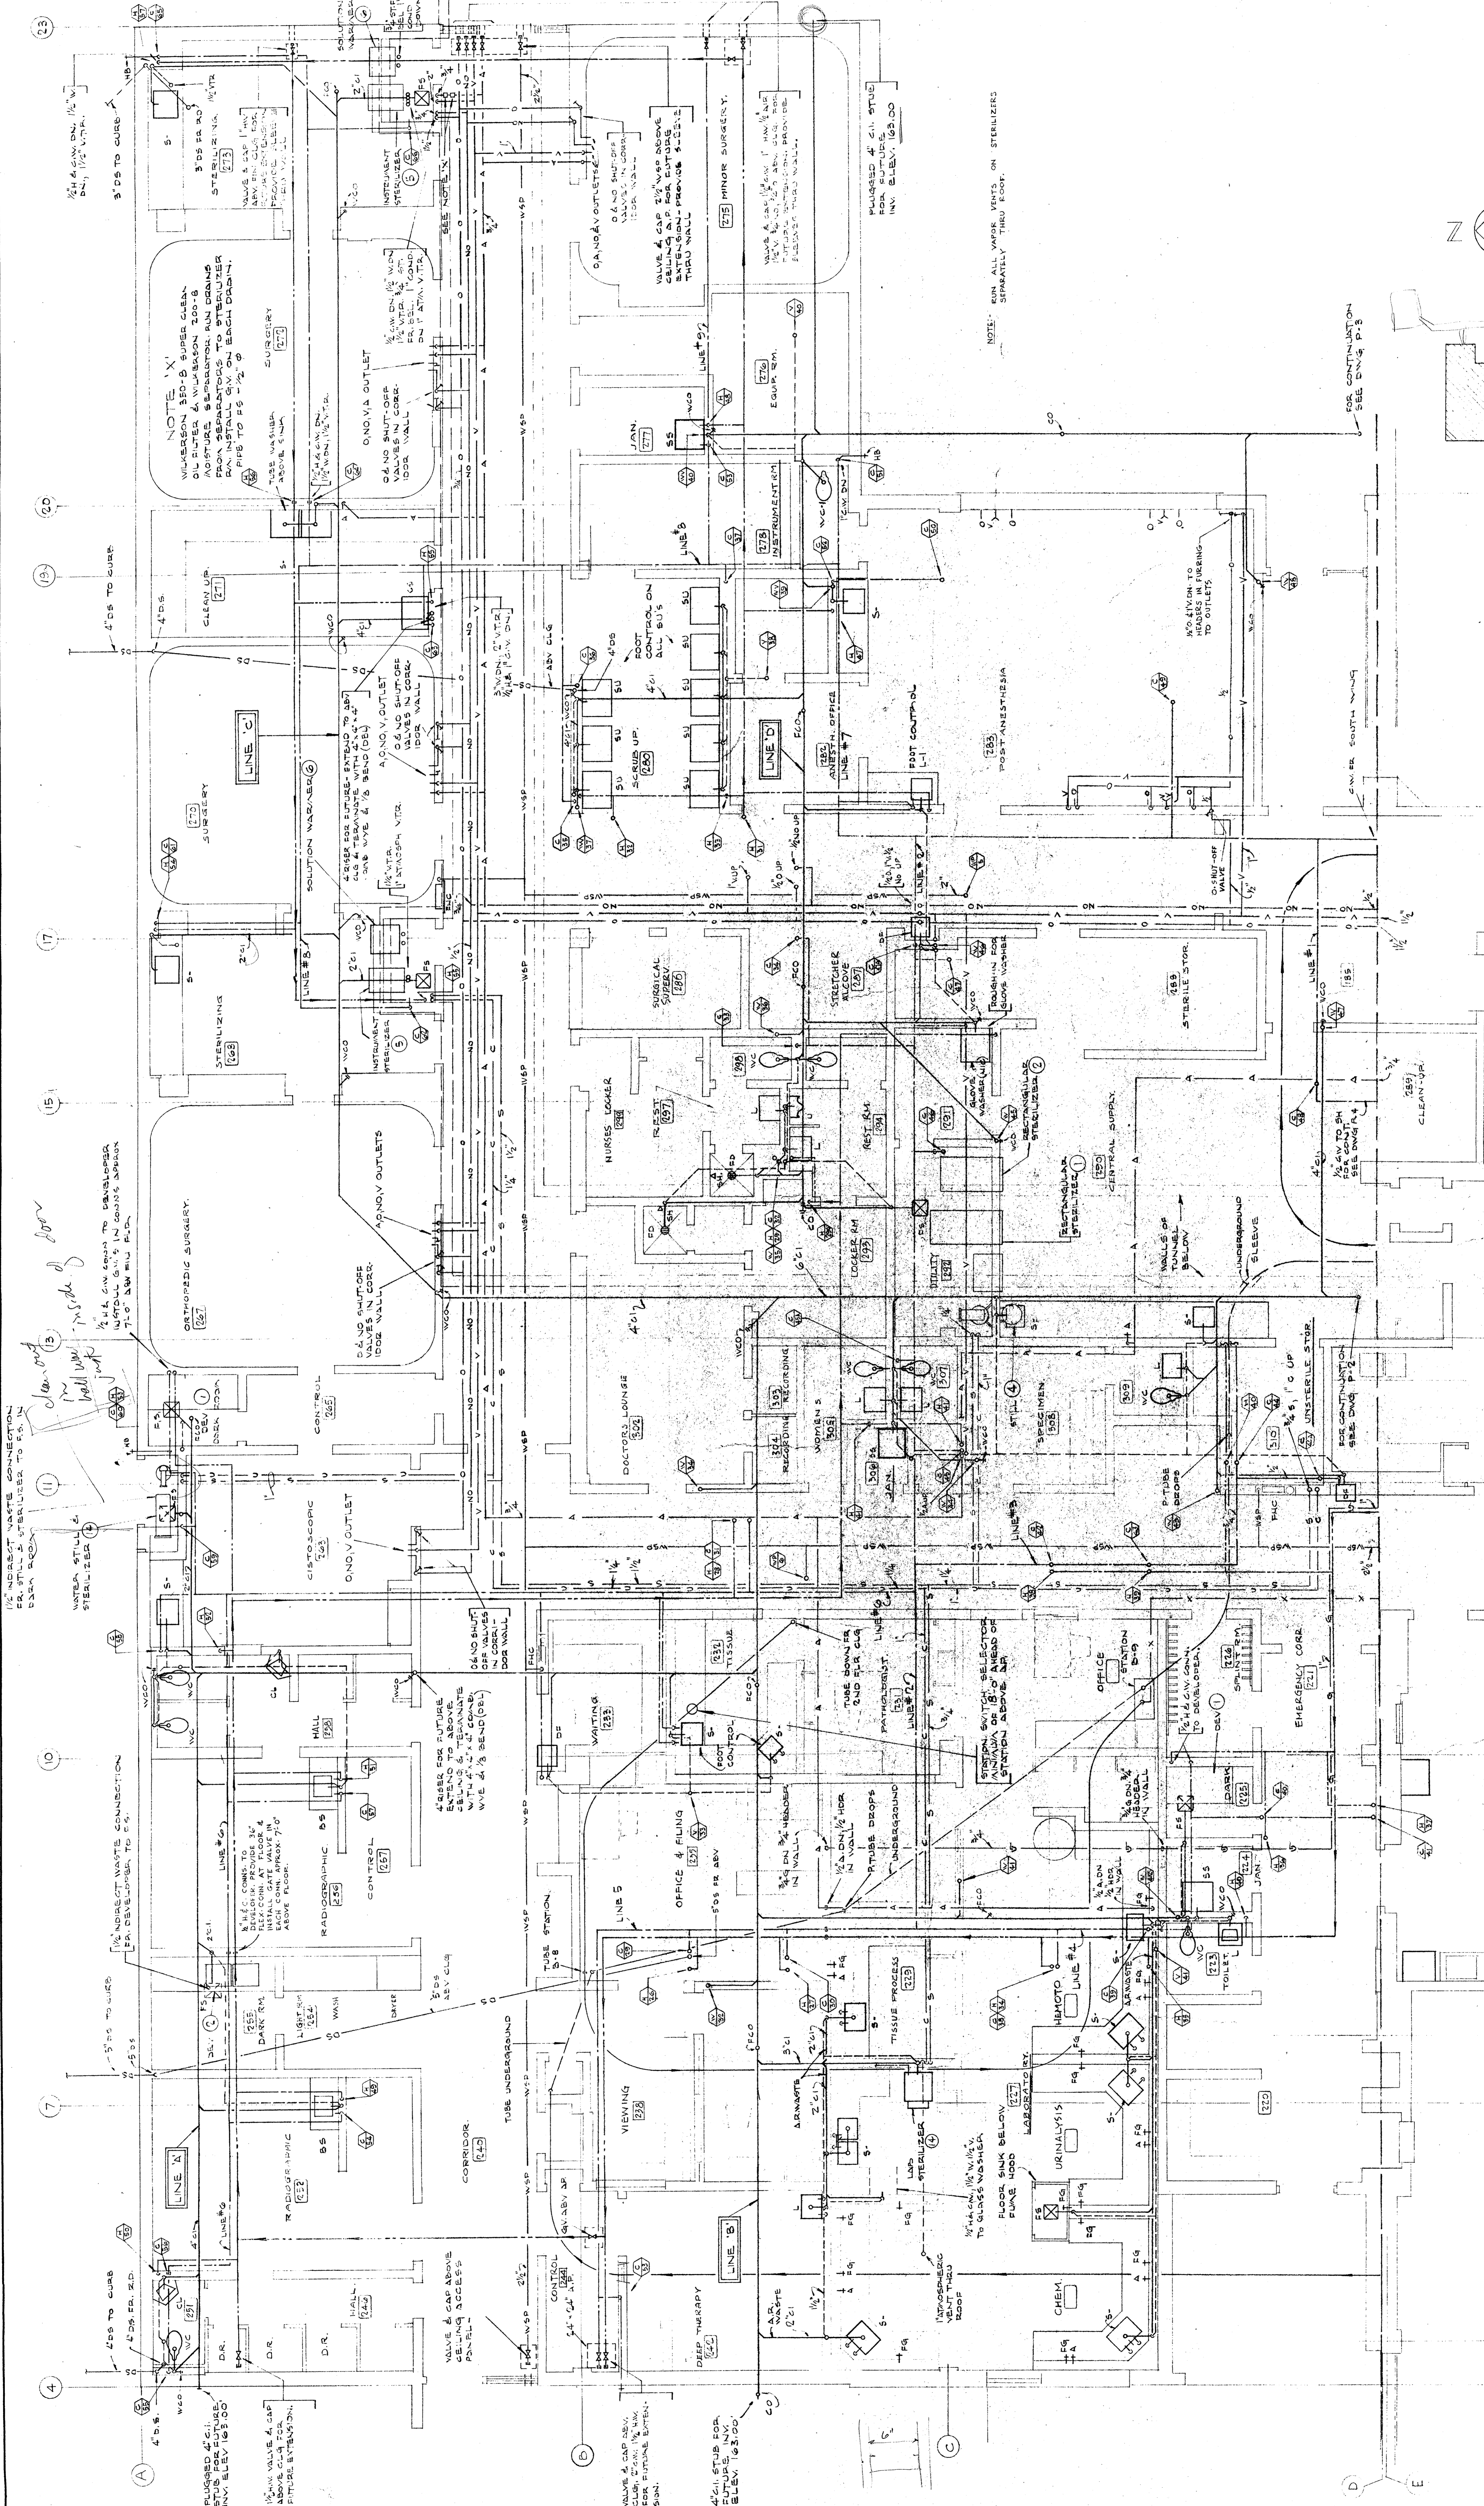


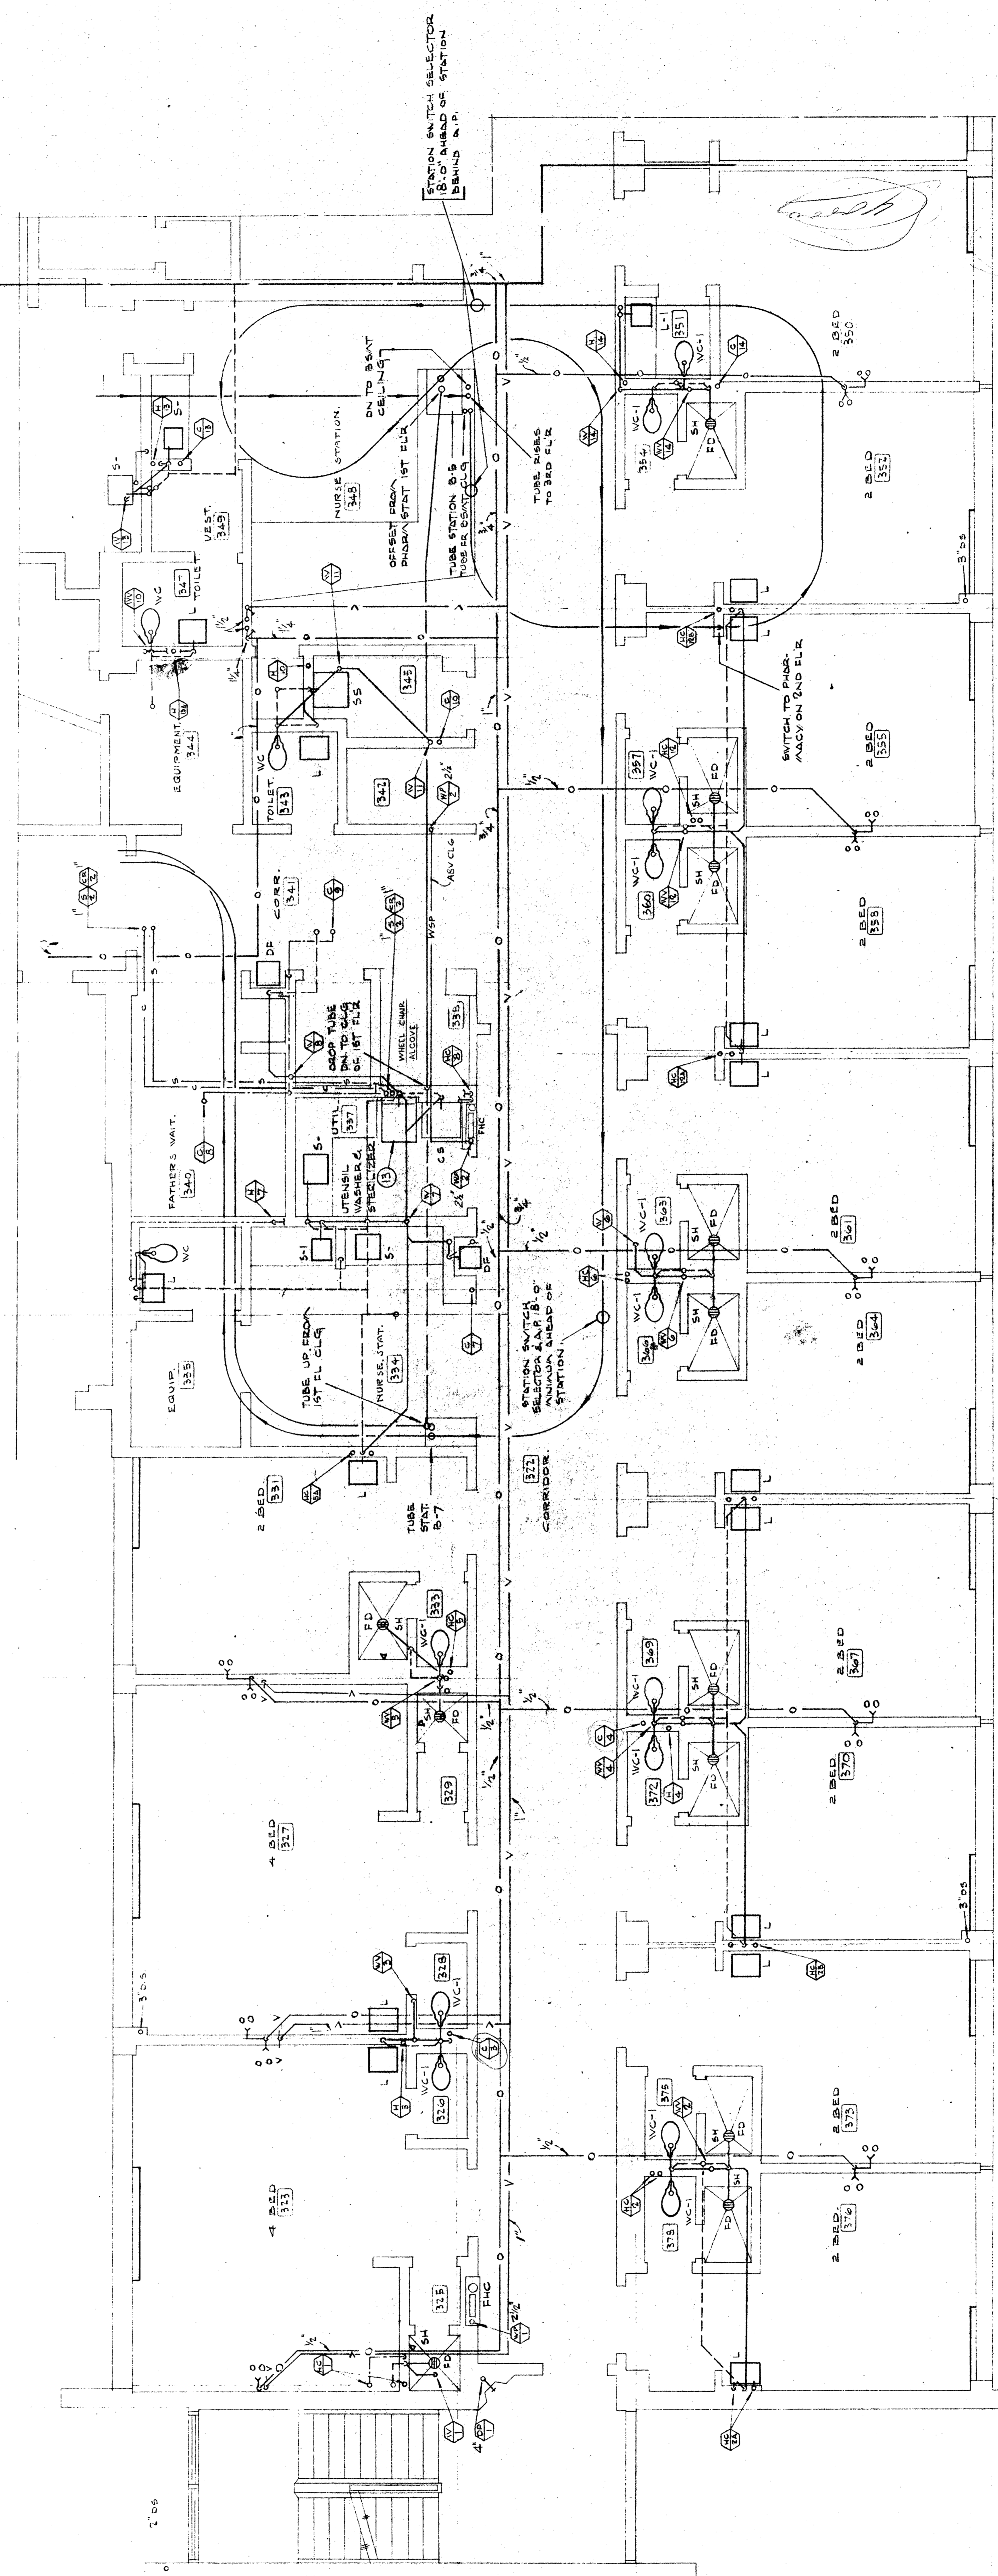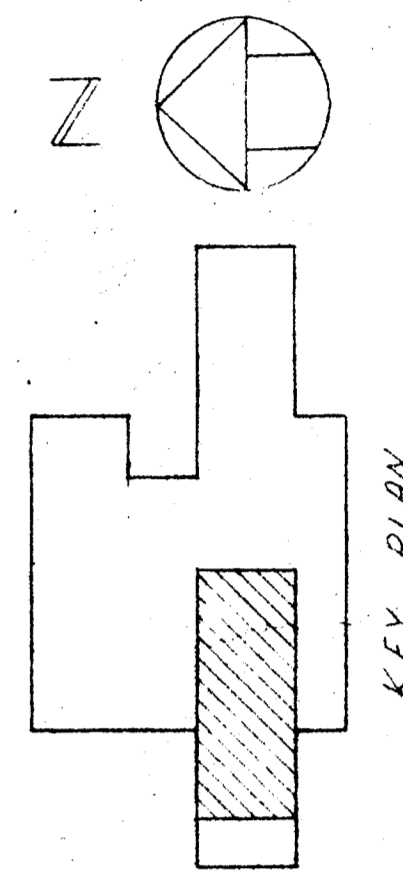

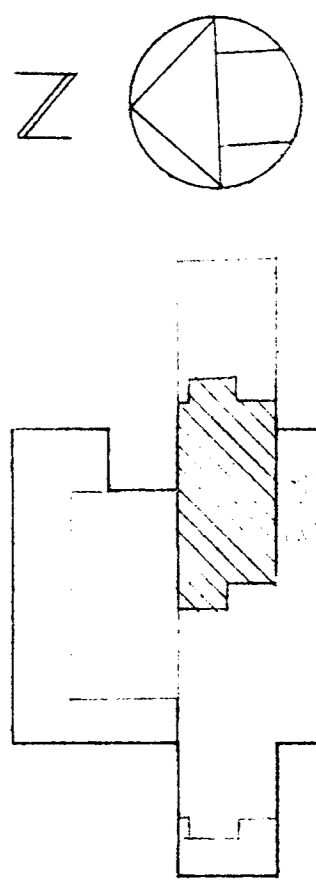

KEY PLAN

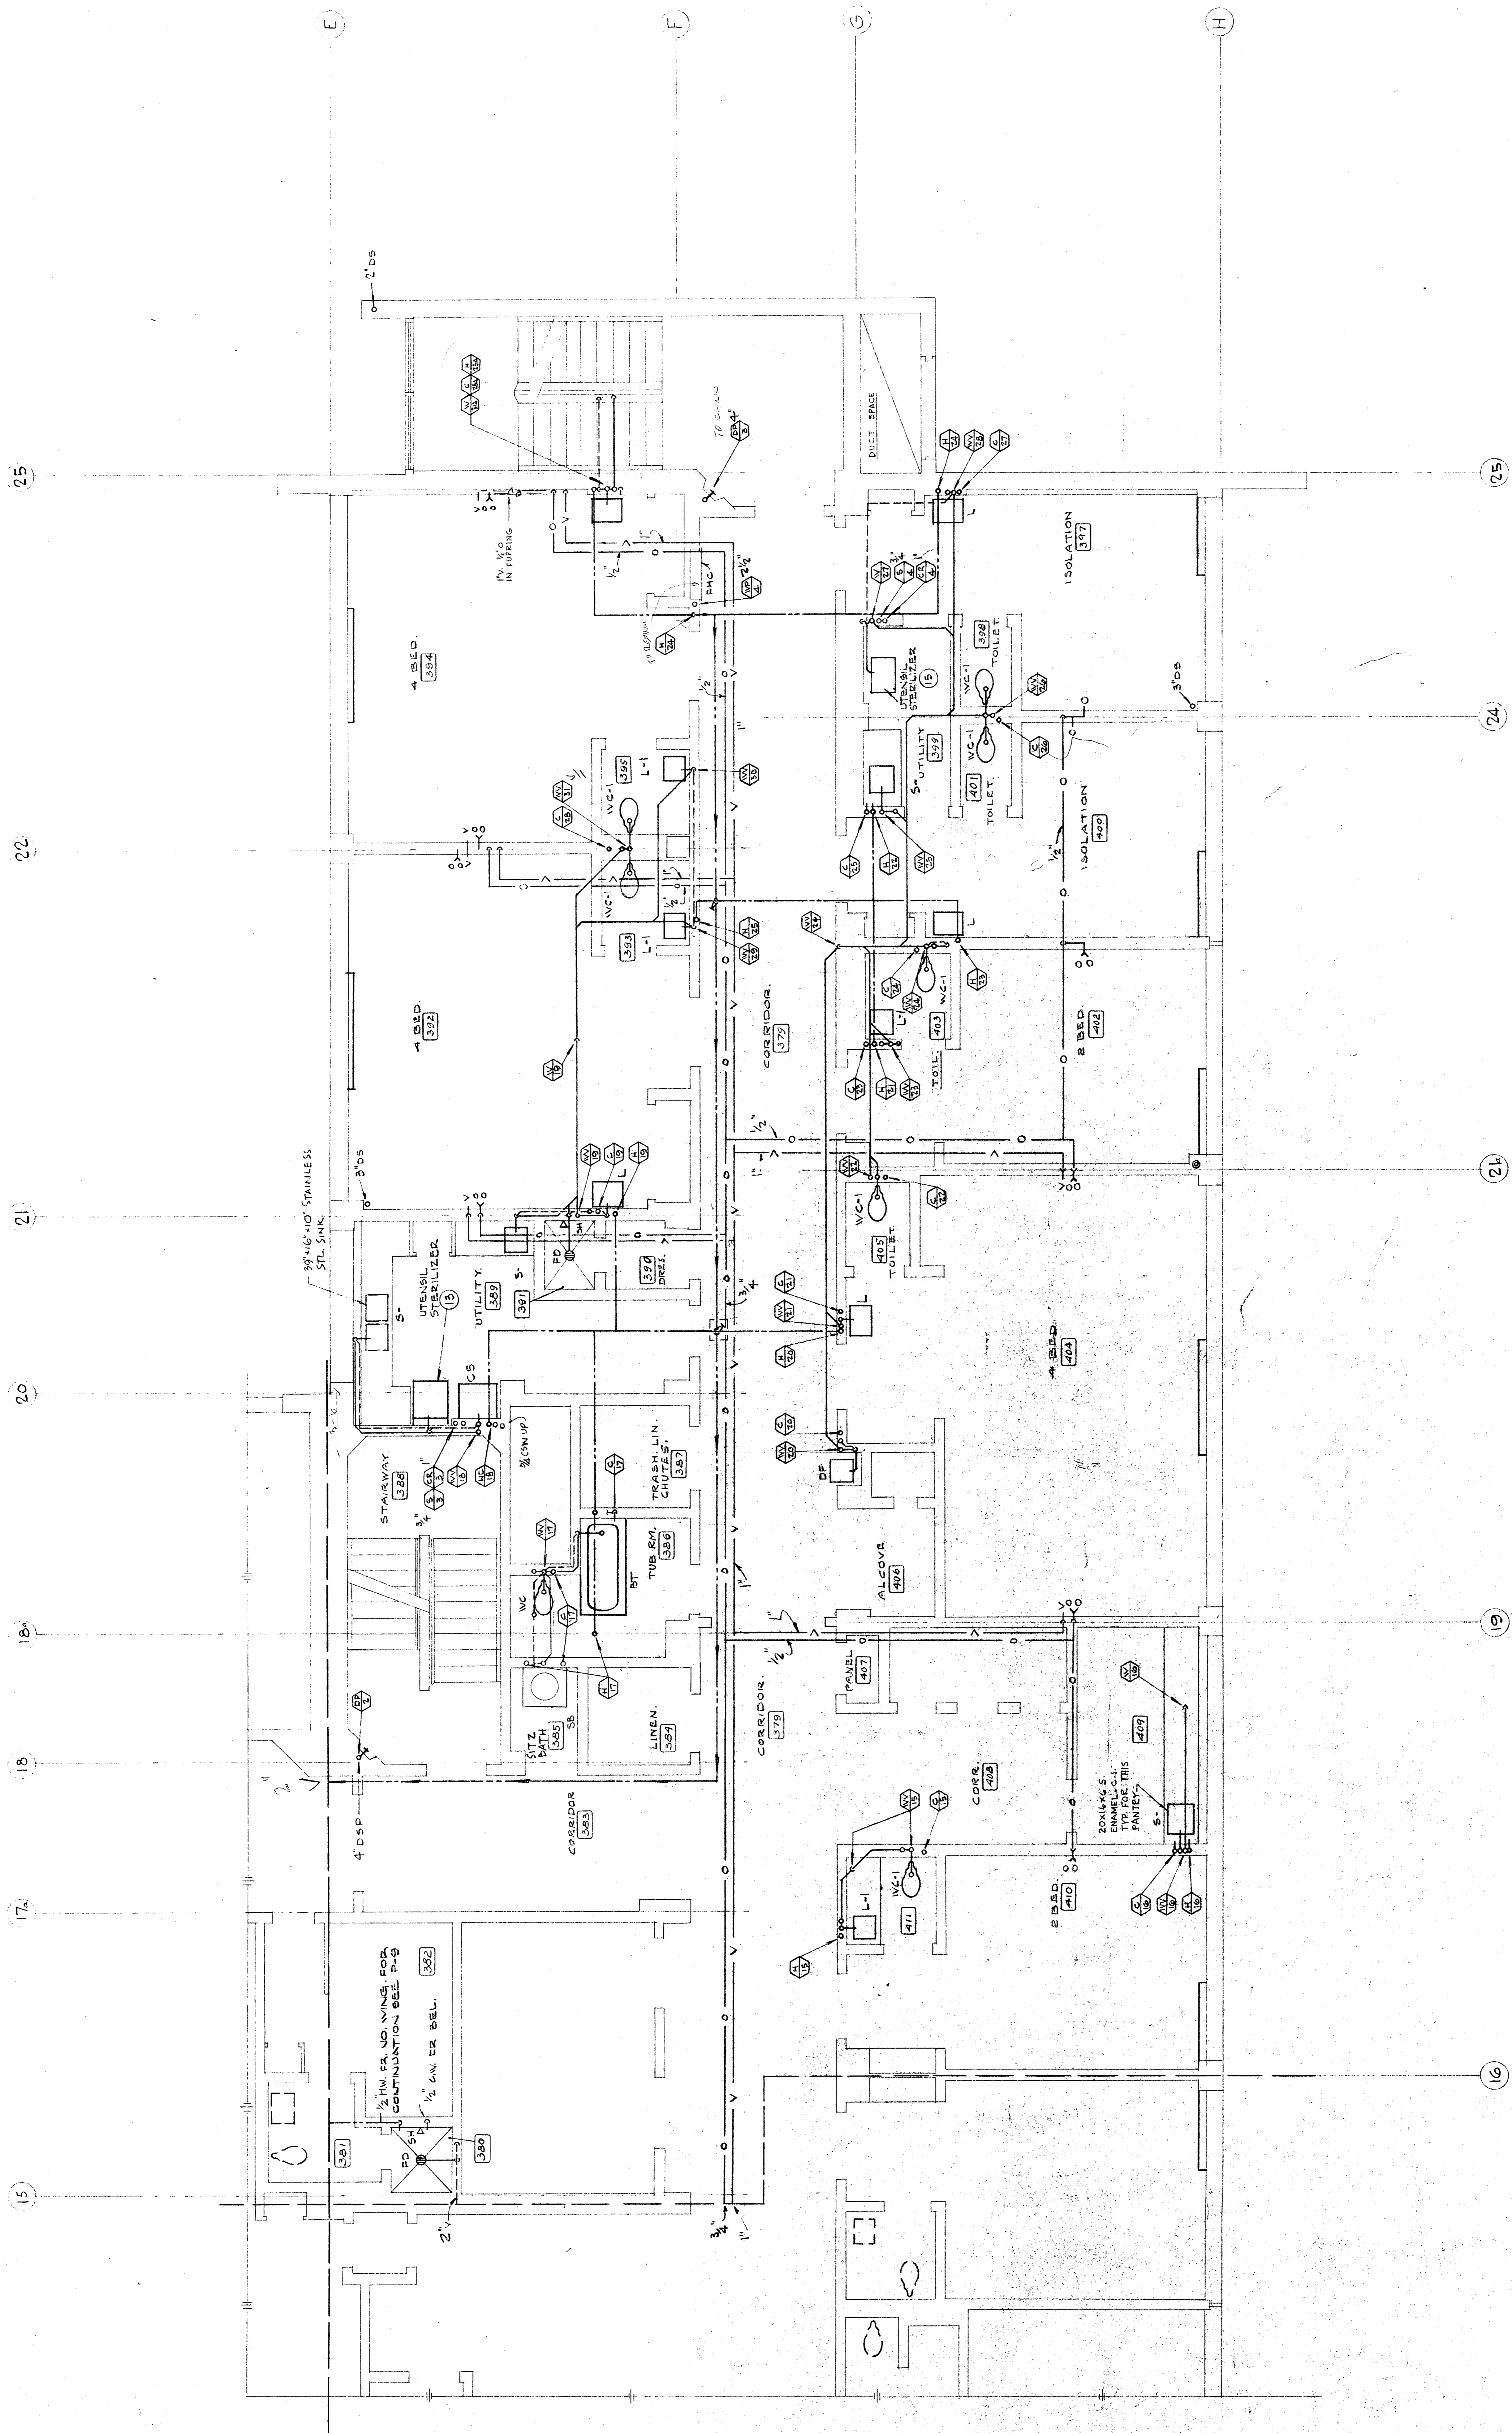

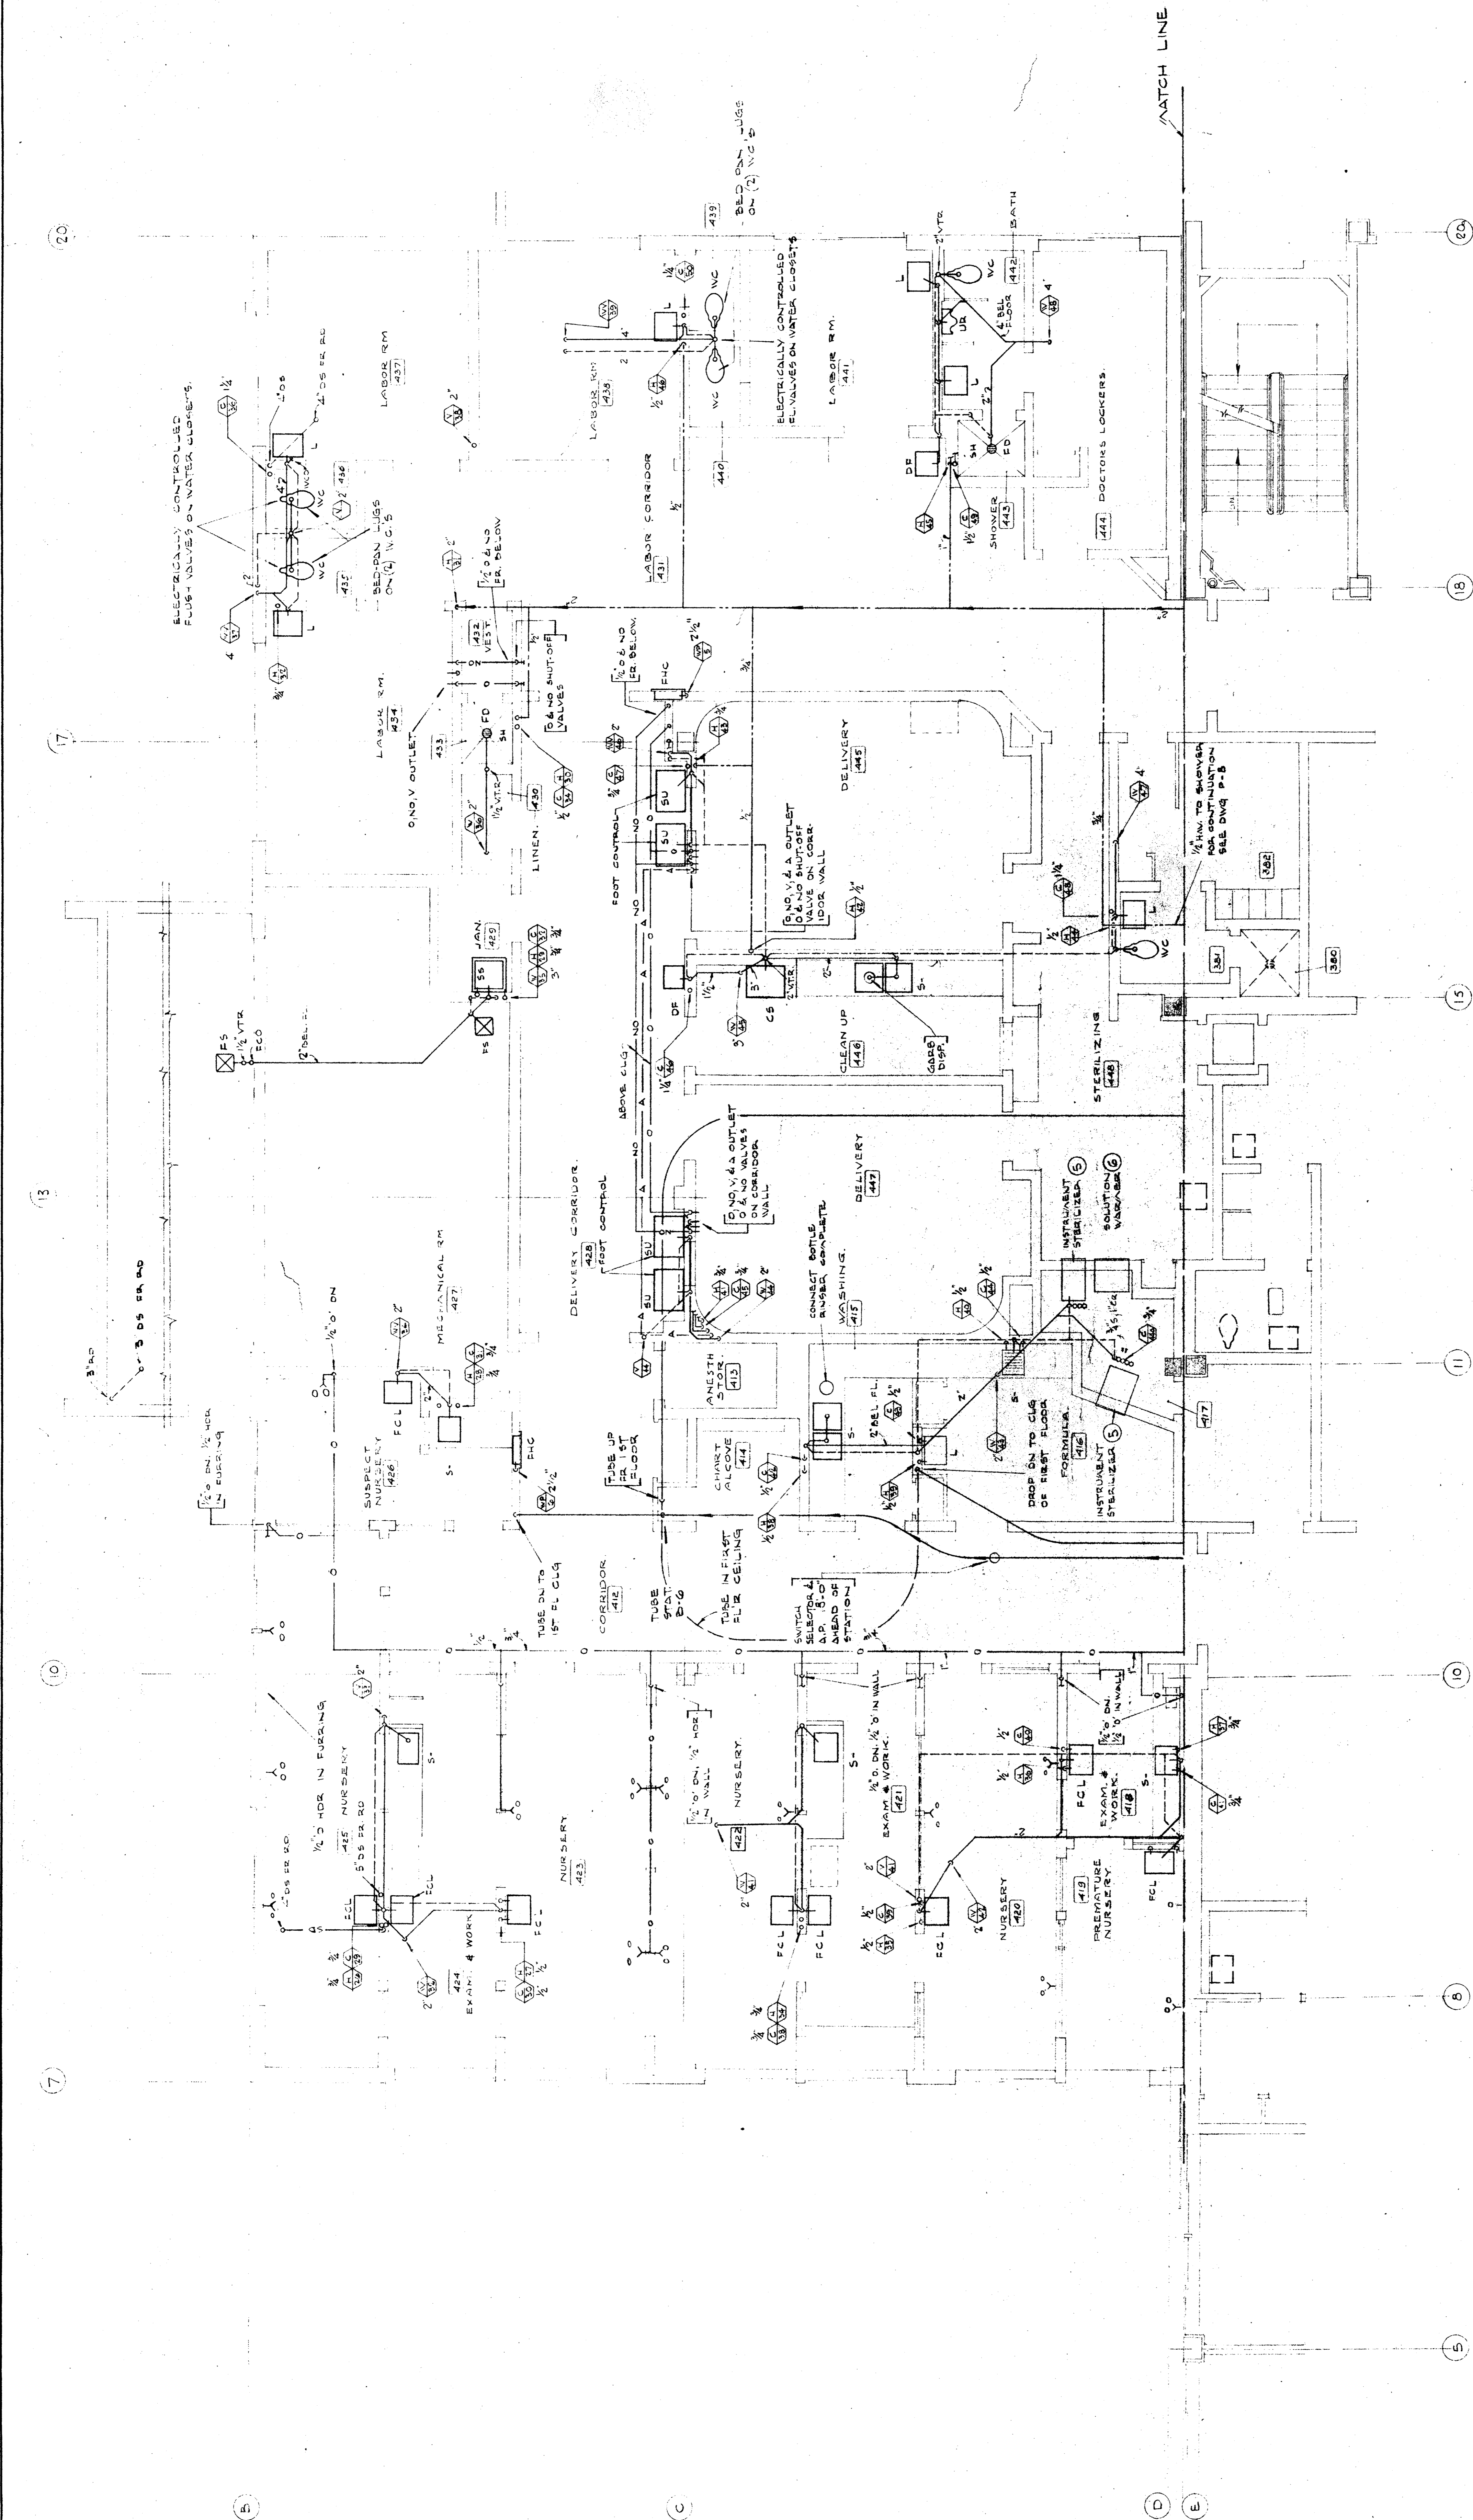
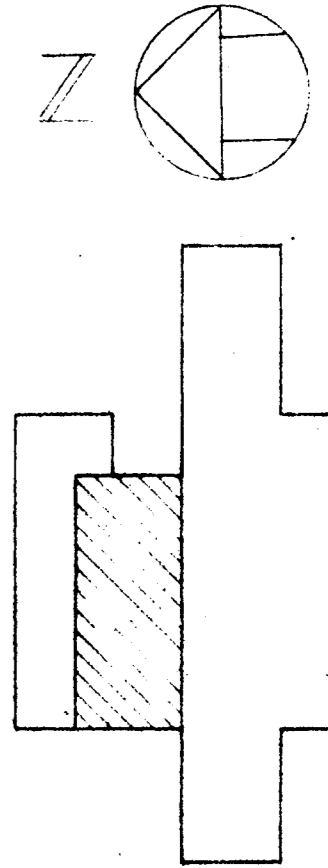


PLUMBING - THIRD FLOOR - WEST
SOUTH BAY HOSPITAL
SOUTH BAY HOSPITAL DISTRICT
REDONDO BEACH, CALIFORNIA


WALKER • KALIONZES • KLINGERMAN
ARCHITECTS
LOS ANGELES, CALIFORNIA
AUGUST W. KOENIG
HOSPITAL CONSULTANT

HENRY M. LAVINE
STRUCTURAL ENGINEER
SAMUEL L. KAYE
MECHANICAL ENGINEER
FOSTER K. SAMPSON
ELECTRICAL ENGINEER

REVISIONS

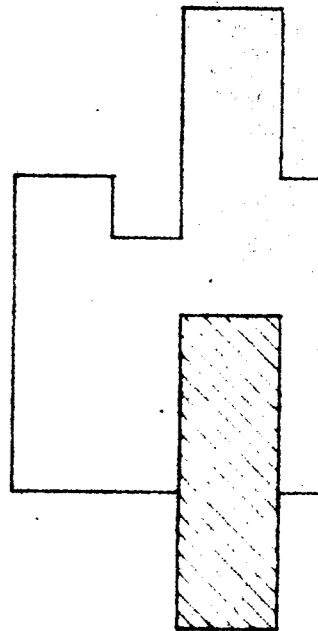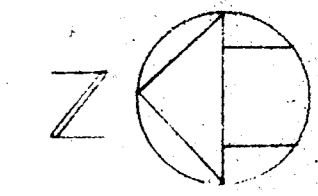

KEY PLAN

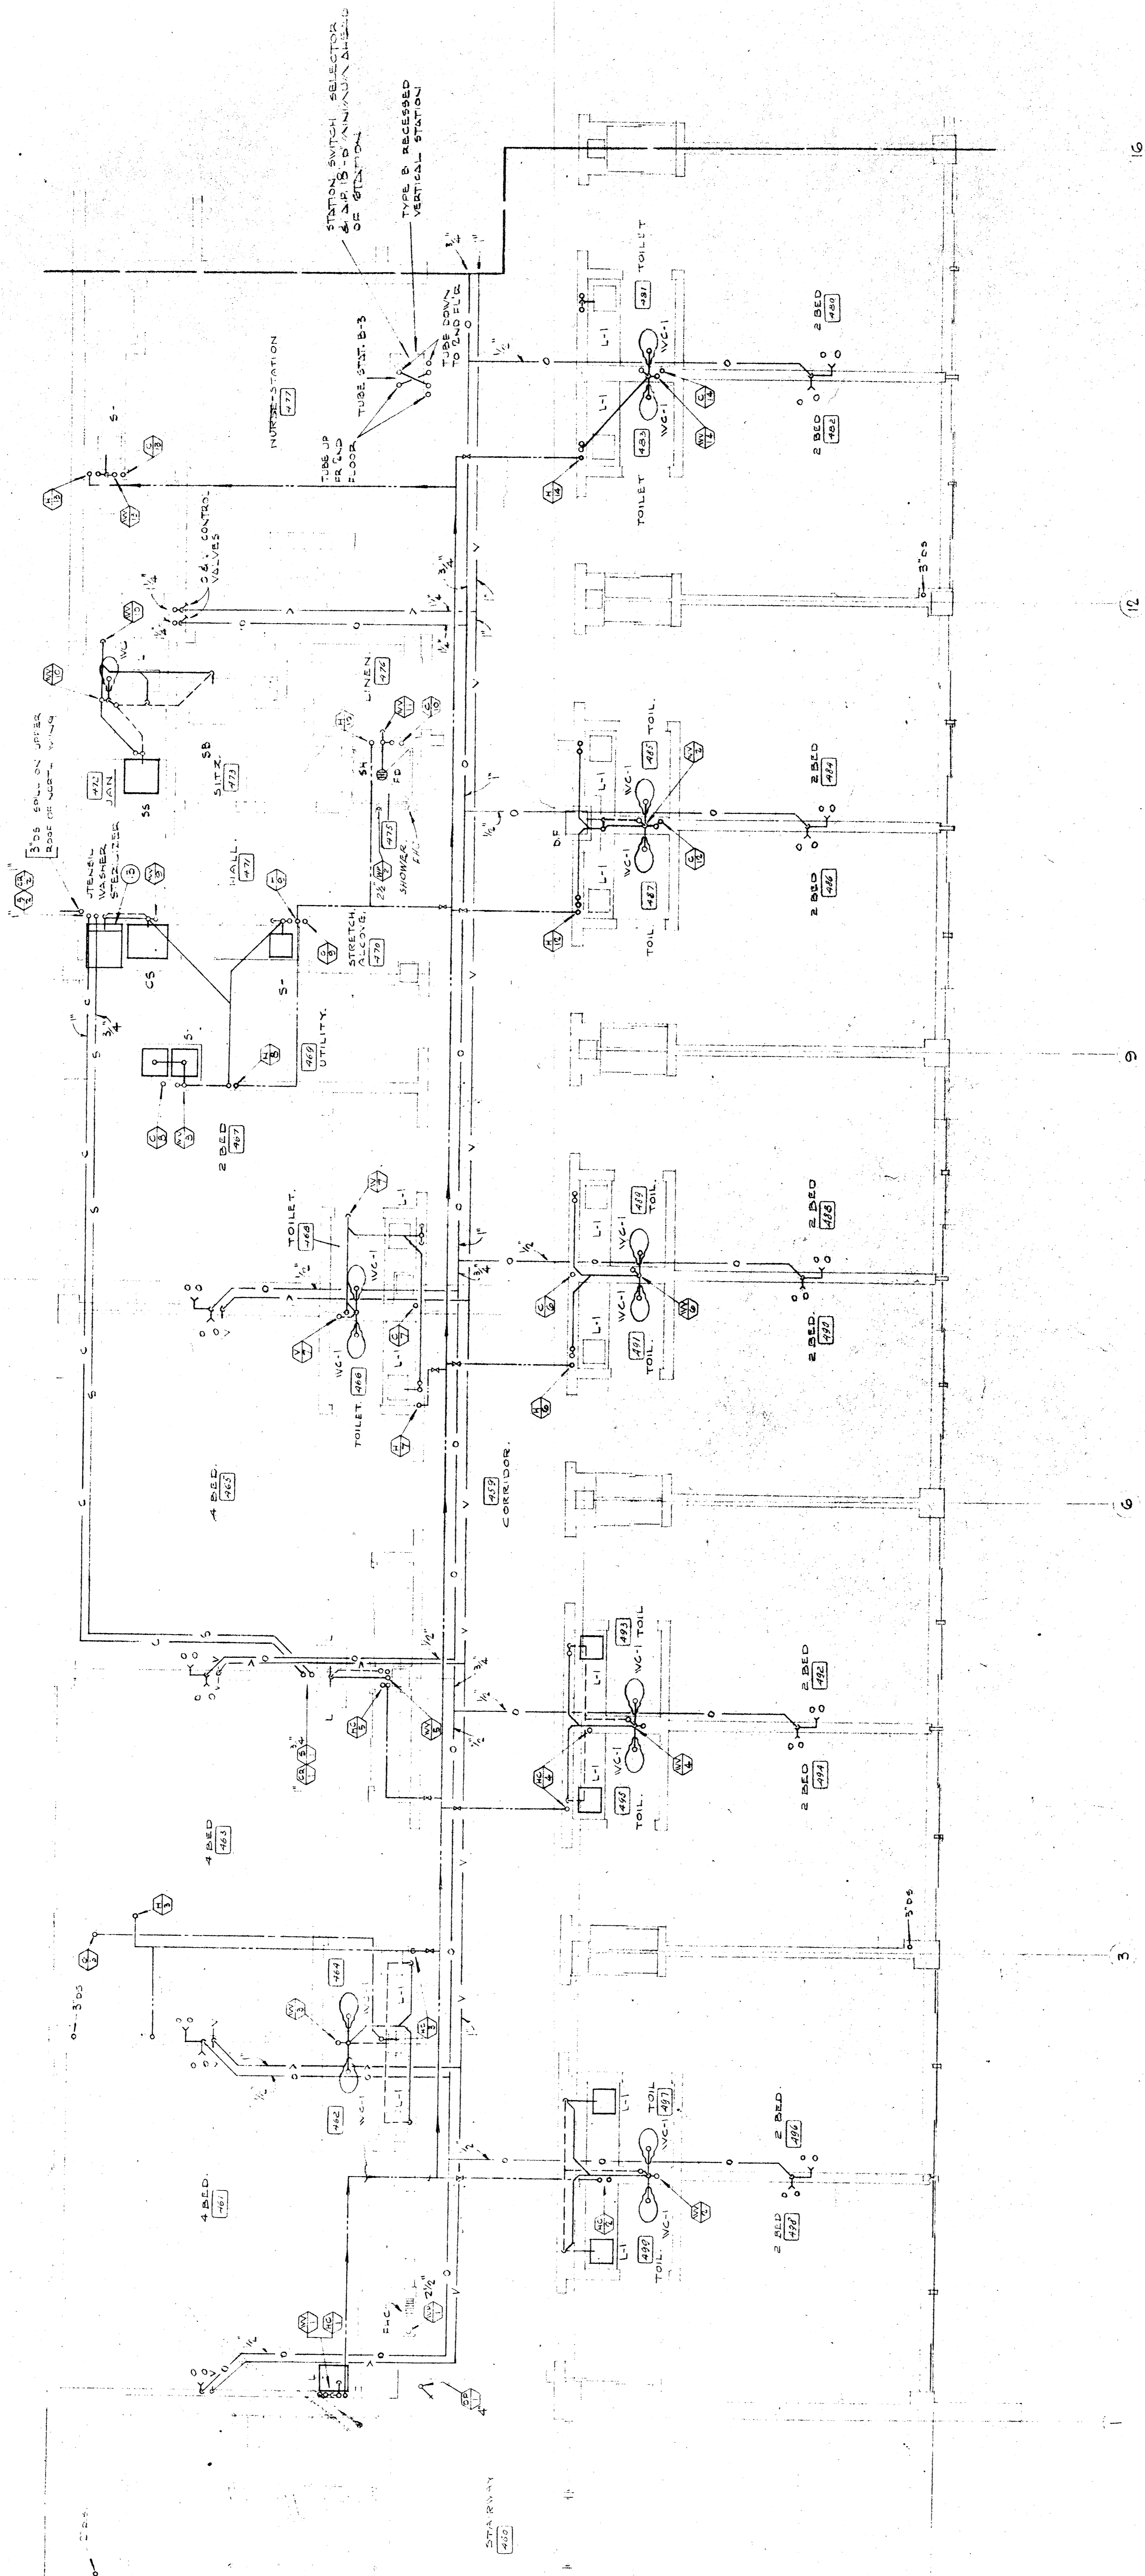



CHECKED
DRAWN BY
DATE 12-18-52



PLUMBING-FOURTH FLOOR WEST
SOUTH BAY HOSPITAL
SOUTH BAY HOSPITAL DISTRICT
REDONDO BEACH, CALIFORNIA

WALKER • KALONZES • KLINGERMAN
ARCHITECTS
LOS ANGELES, CALIFORNIA
AUGUST W. KOENIG
HOSPITAL CONSULTANT

HENRY M. LAYNE
STRUCTURAL ENGINEER
SAMUEL L. KAYE
MECHANICAL ENGINEER
FOSTER K. SAMPSON
ELECTRICAL ENGINEER


REVISIONS	
1	
2	
3	
4	
5	

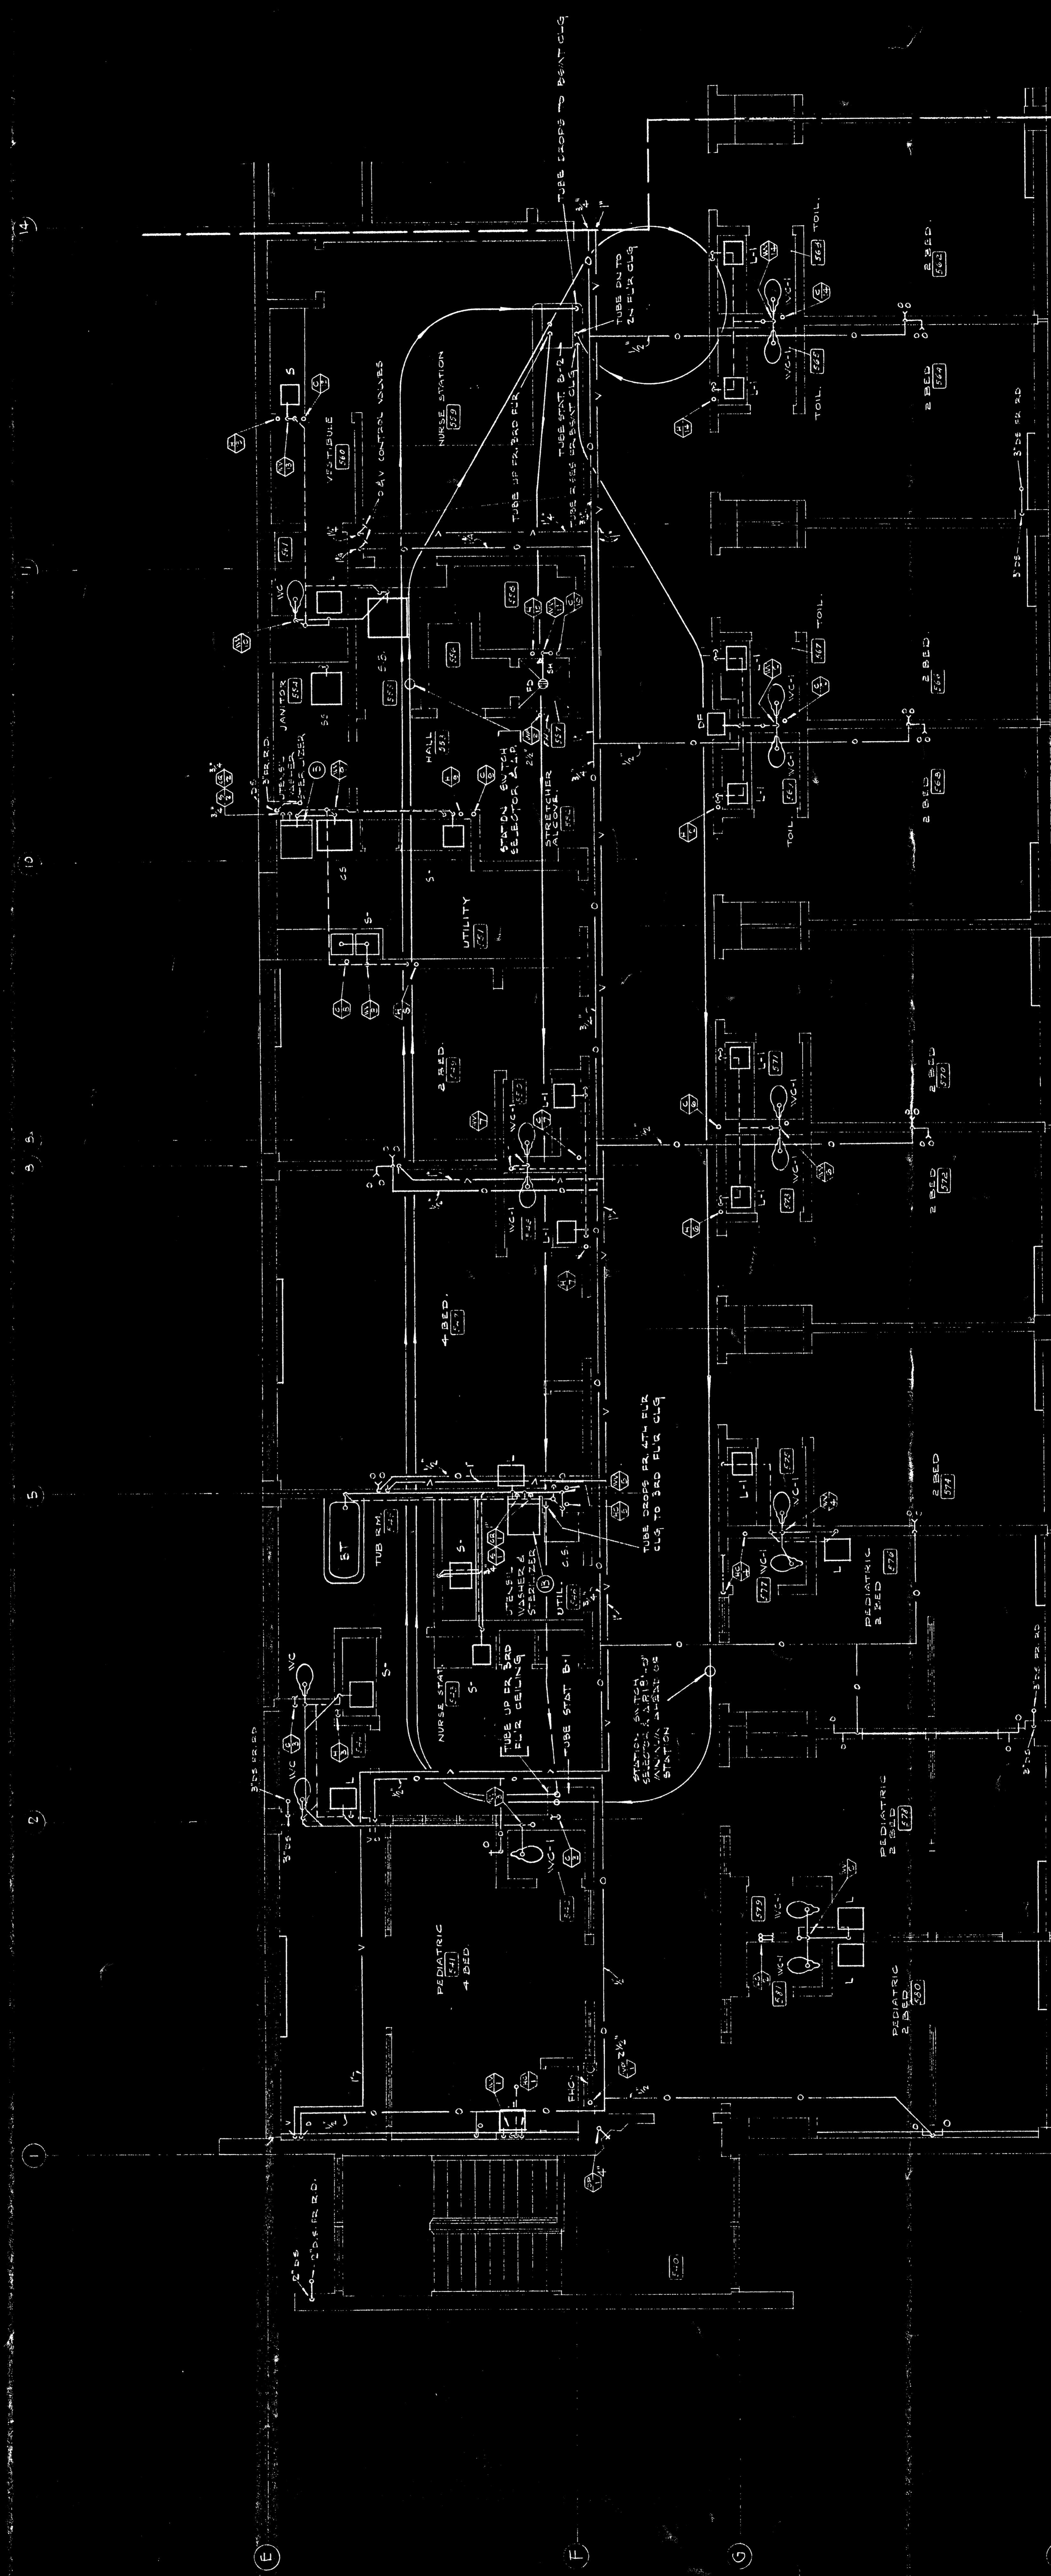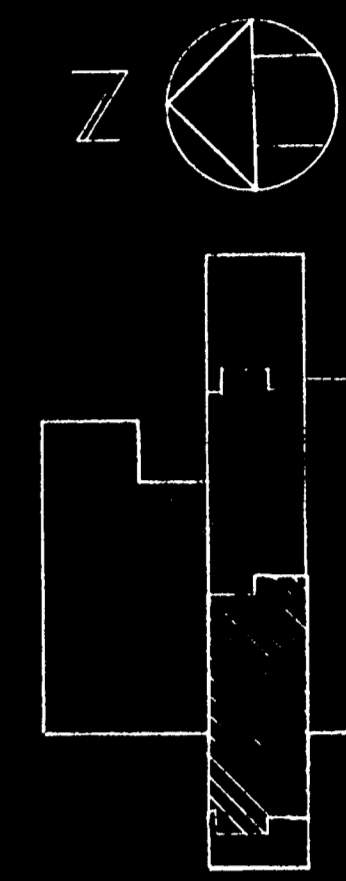



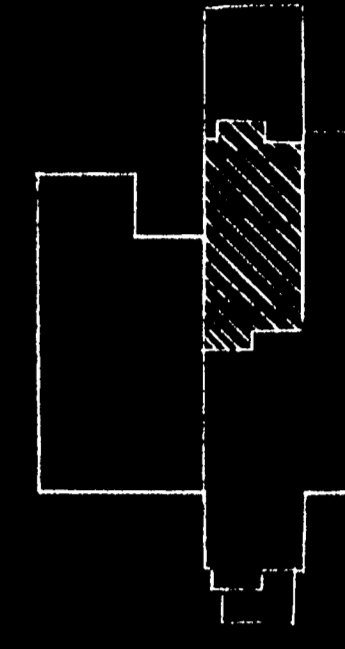
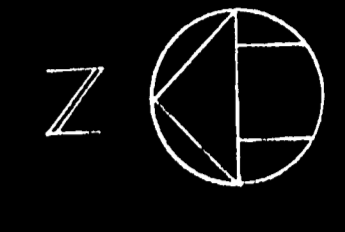


KEY PLAN



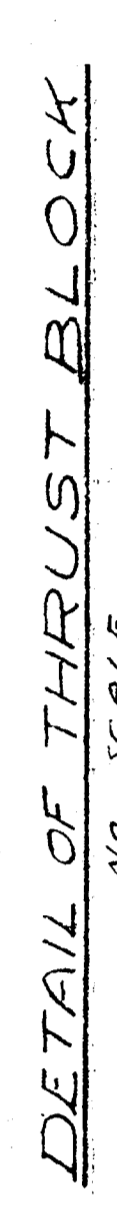

PLAN OF STEAM SNUFFER PIPING IN RANGE HOOD
EXHAUST DUCT

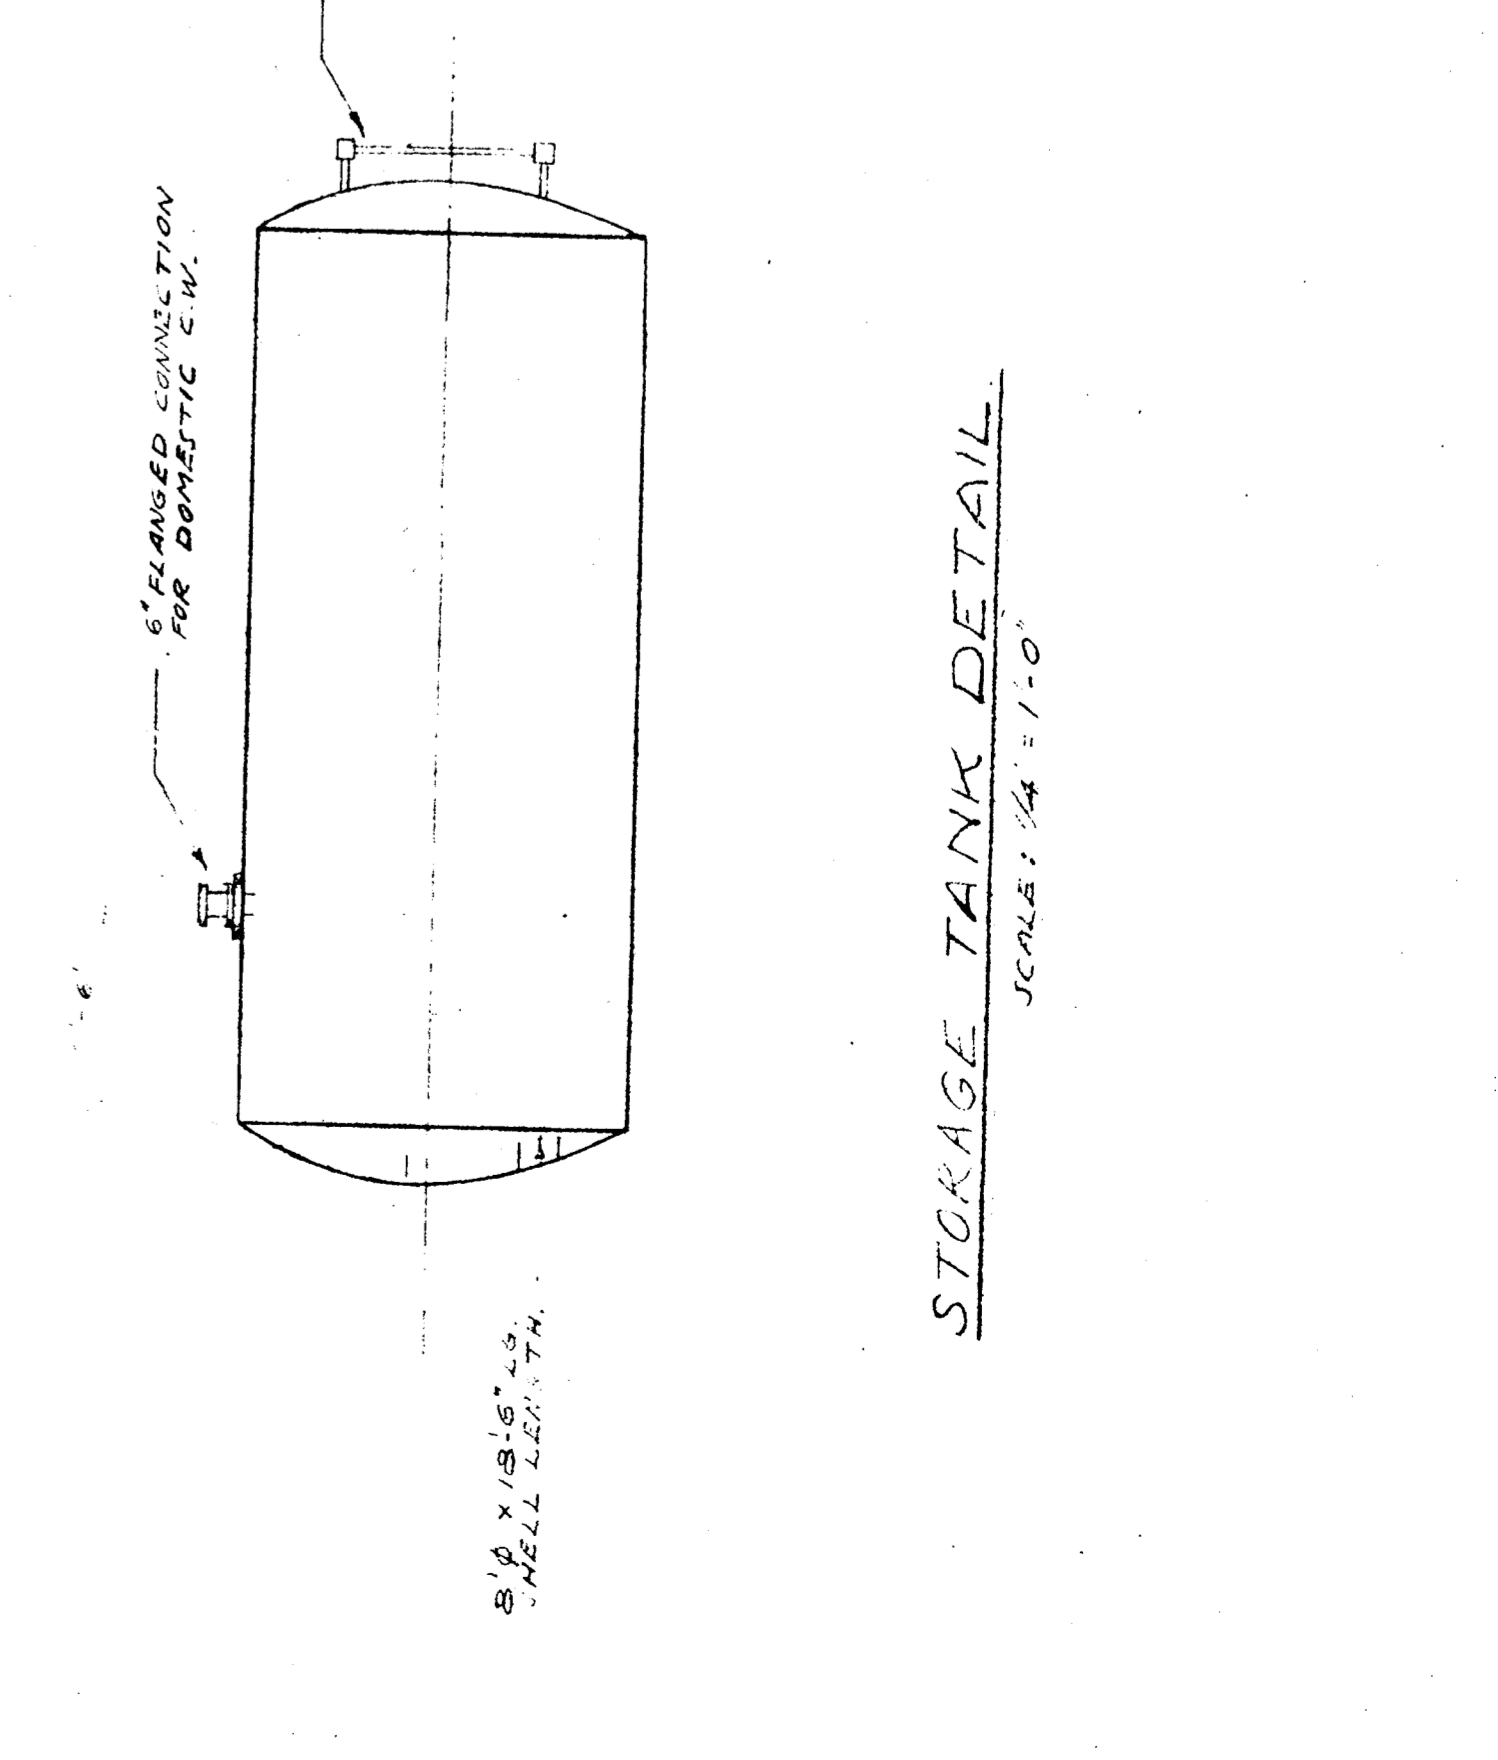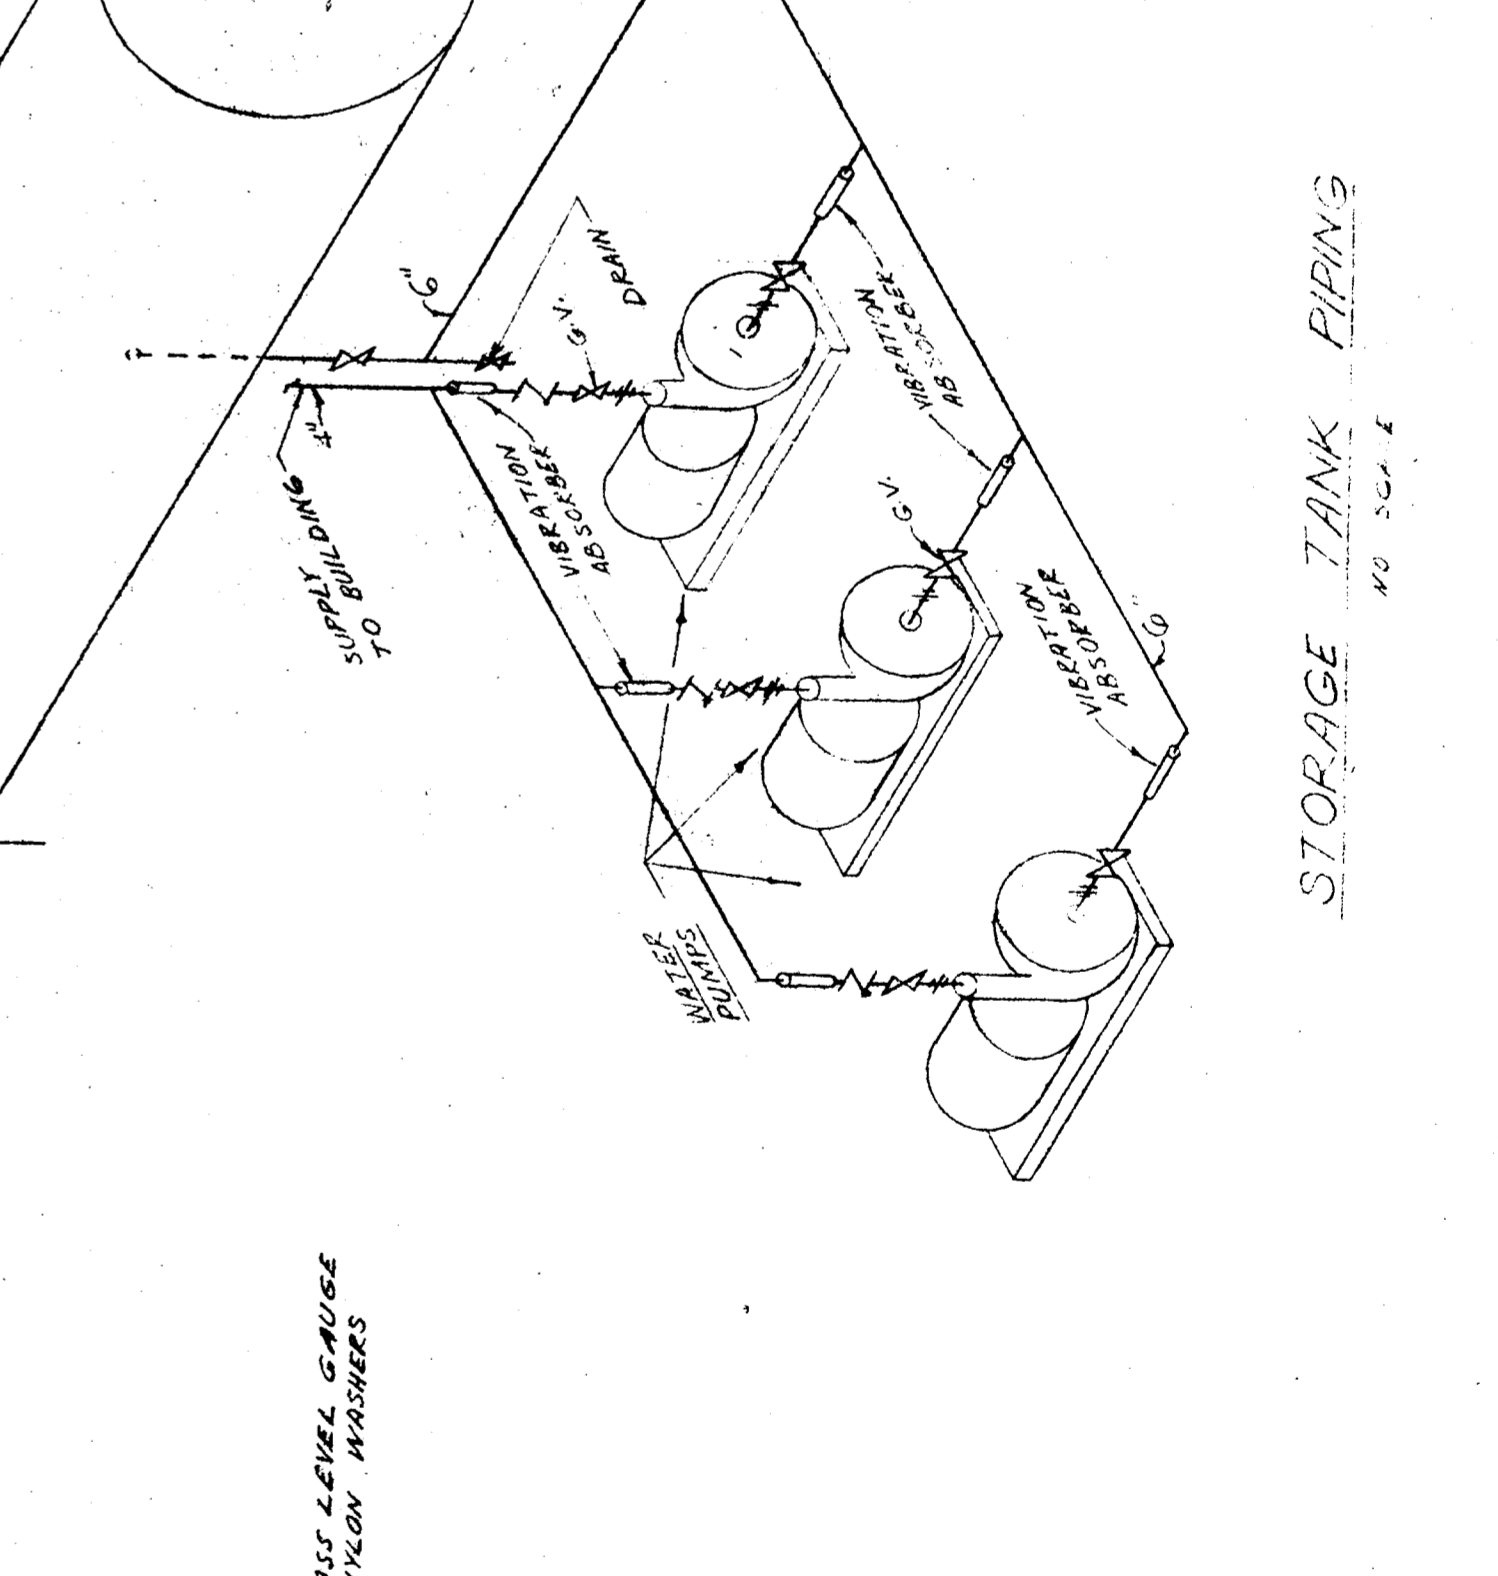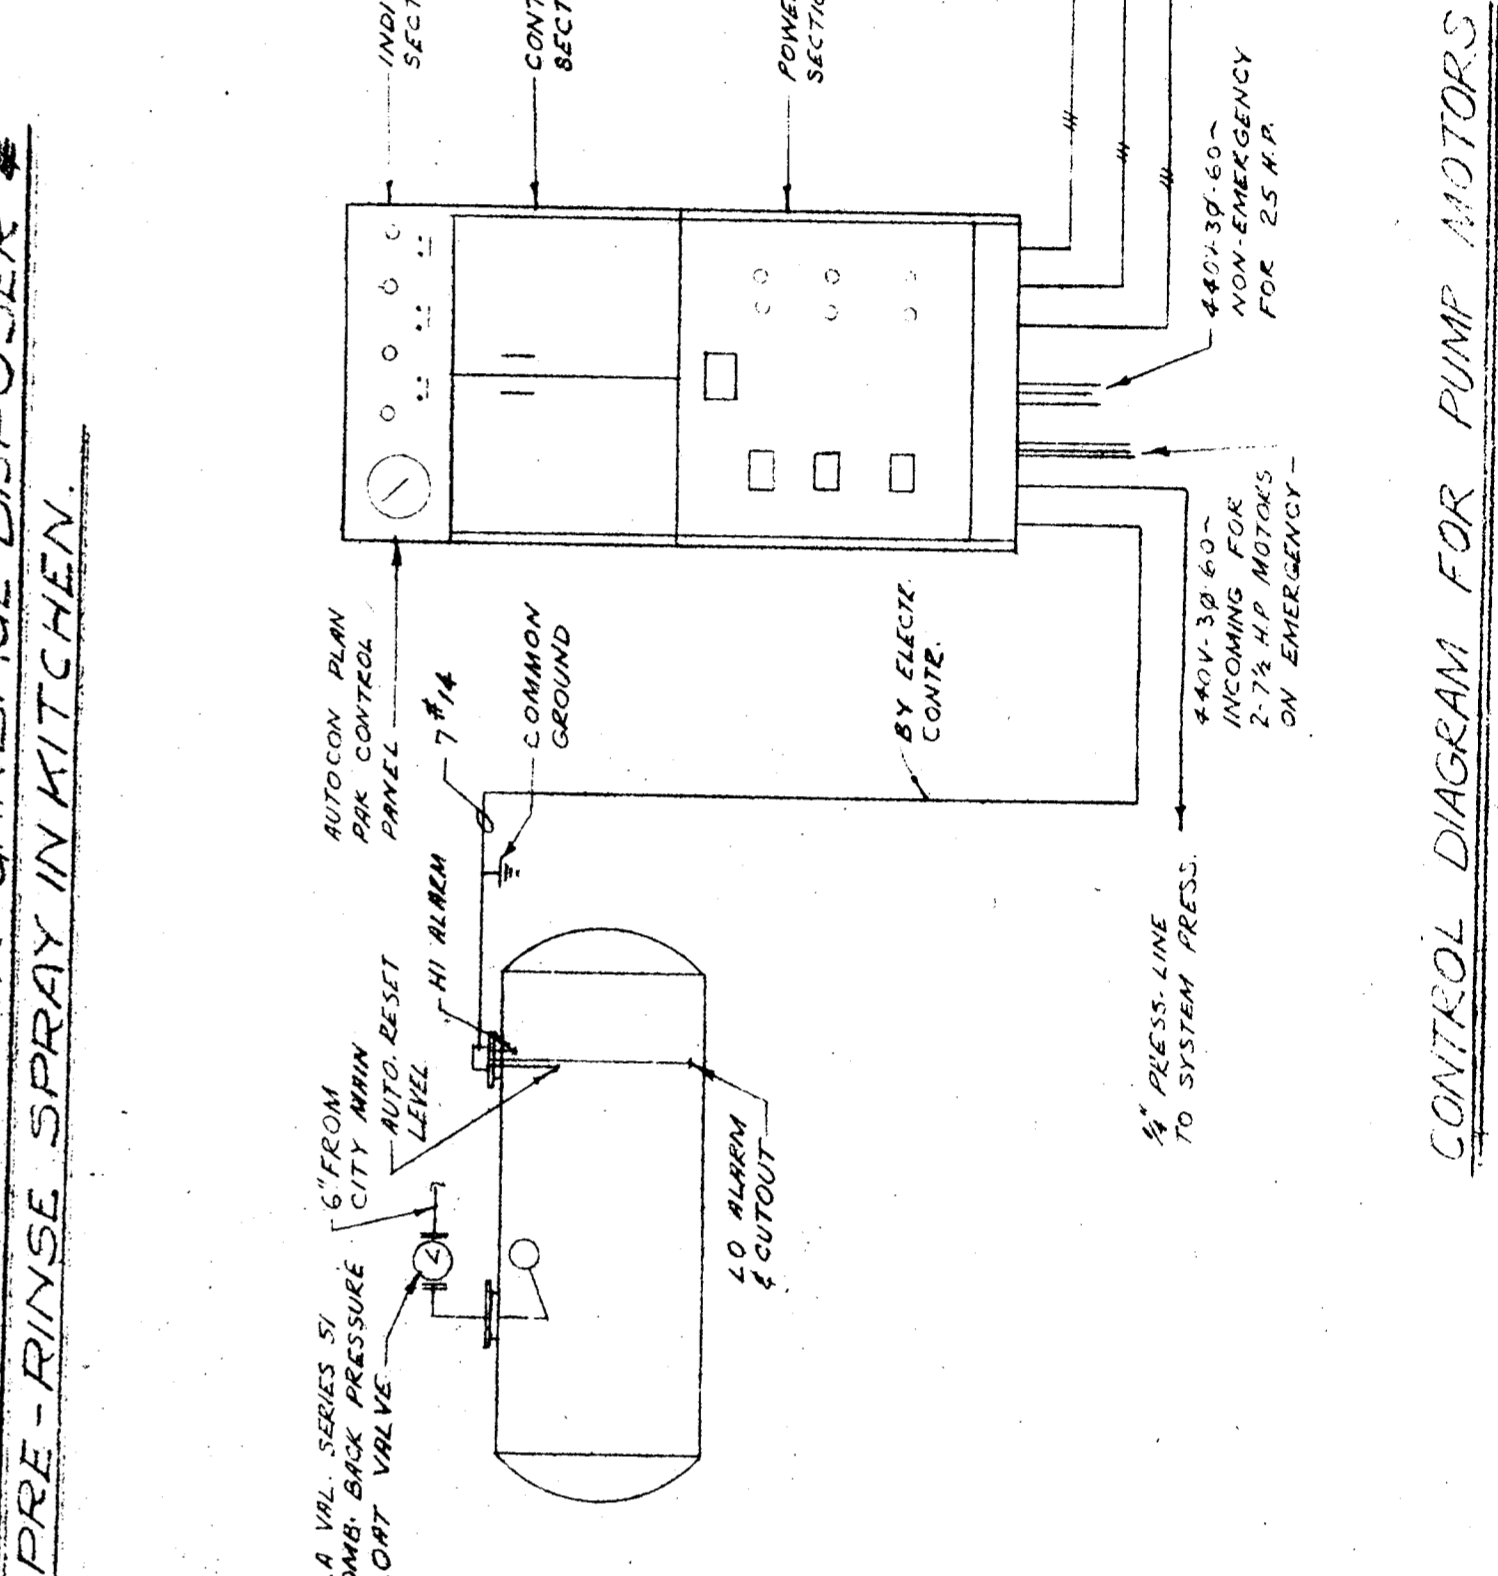
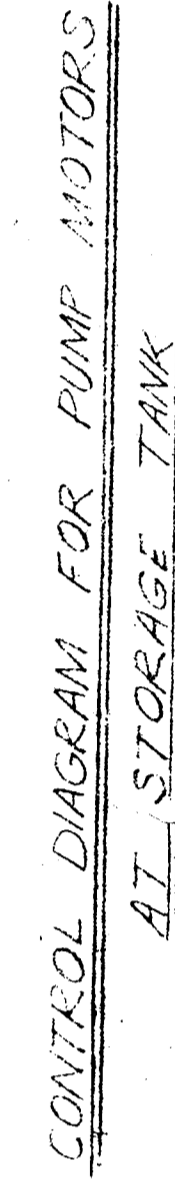


SOUTH BAY HOSPITAL
SOUTH BAY HOSPITAL DISTRICT
RECOND BEACH, CALIFORNIA


WALKER • KALIONZES • KLINGERMAN
A R C H I T E C T S
LOS ANGELES, CALIFORNIA
AUGUST W. KOENIG
HOSPITAL CONSULTANT

HENRY M. LAYNE
STRUCTURAL ENGINEER
SAMUEL L. KAYE
MECHANICAL ENGINEER
FOSTER K. SAMPSON
ELECTRICAL ENGINEER

REVISIONS
1 2 3 4 5

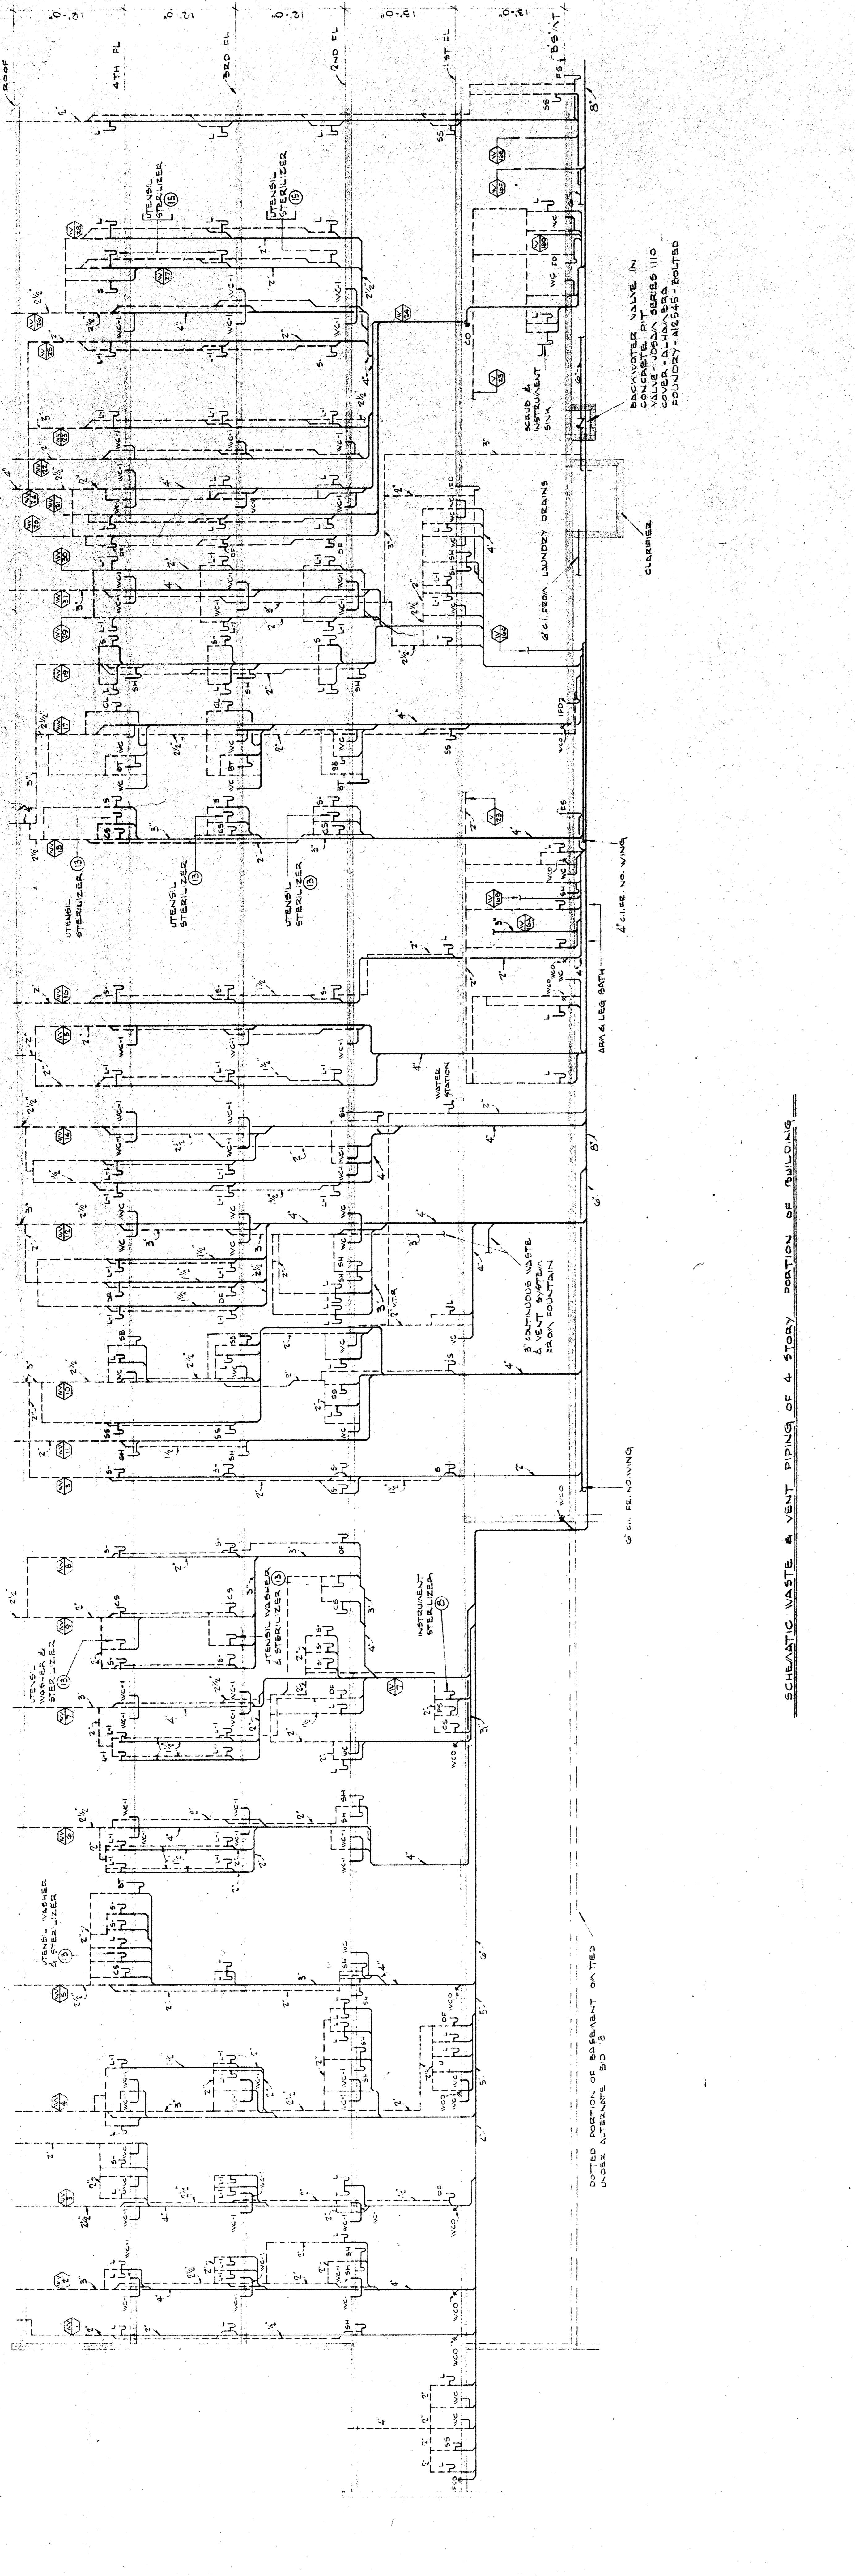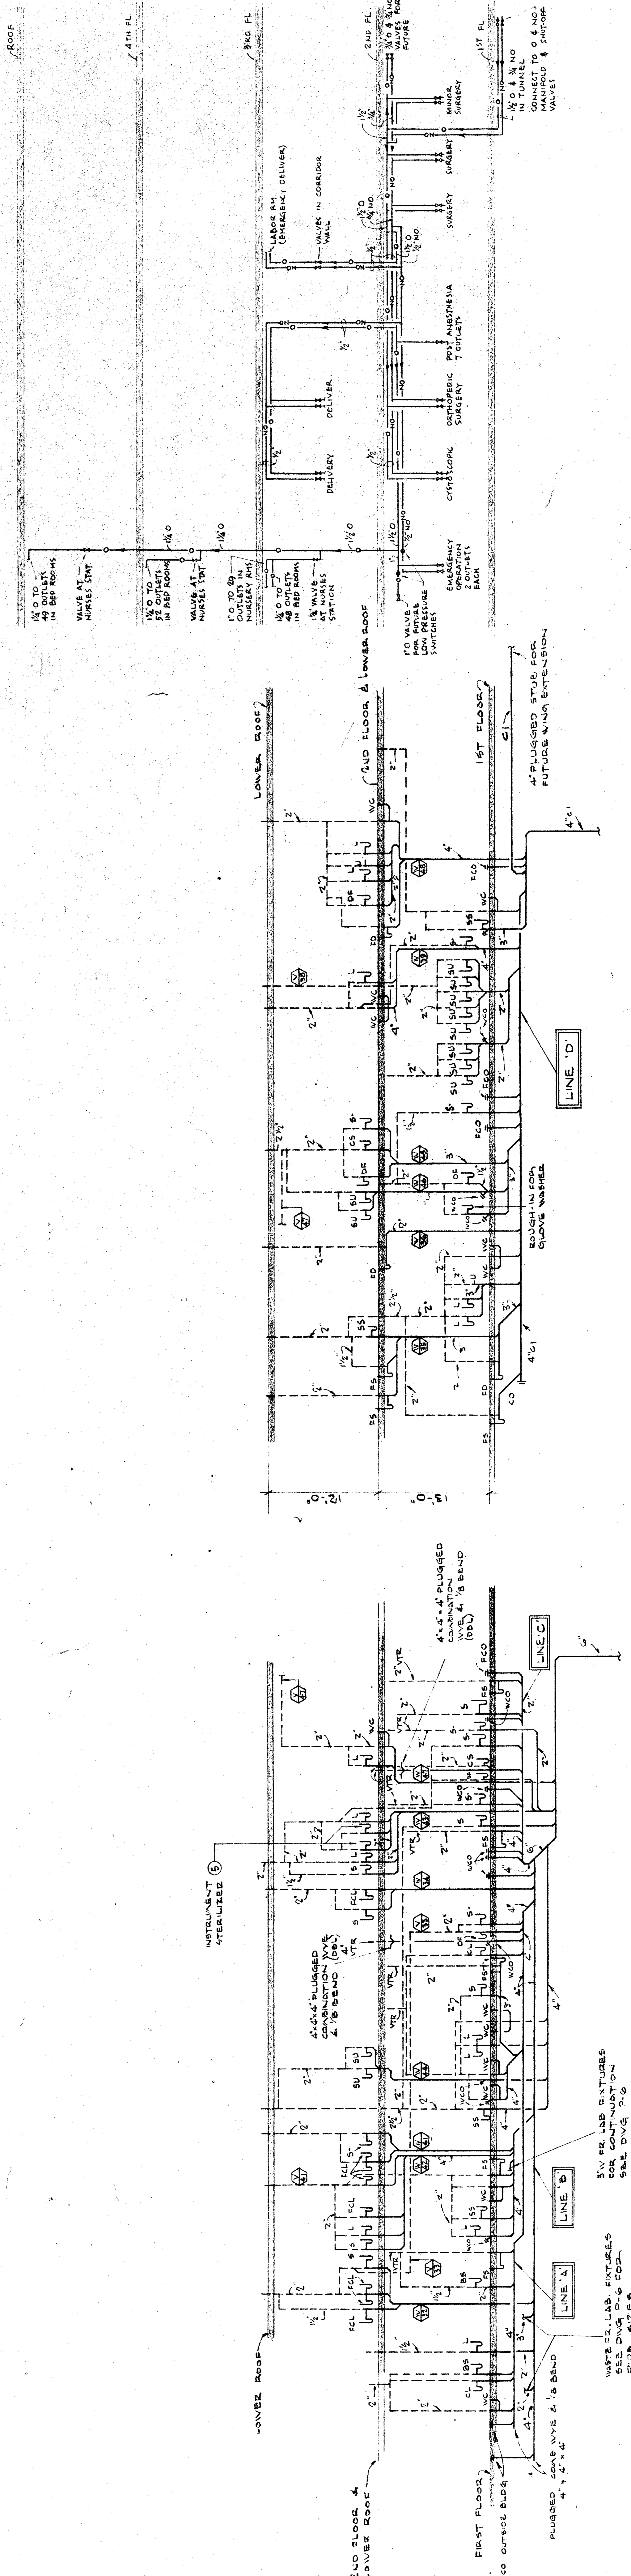

SCHEMATIC WASTE & VENT PIPING OF 4 STORY PORTION OF BUILDING

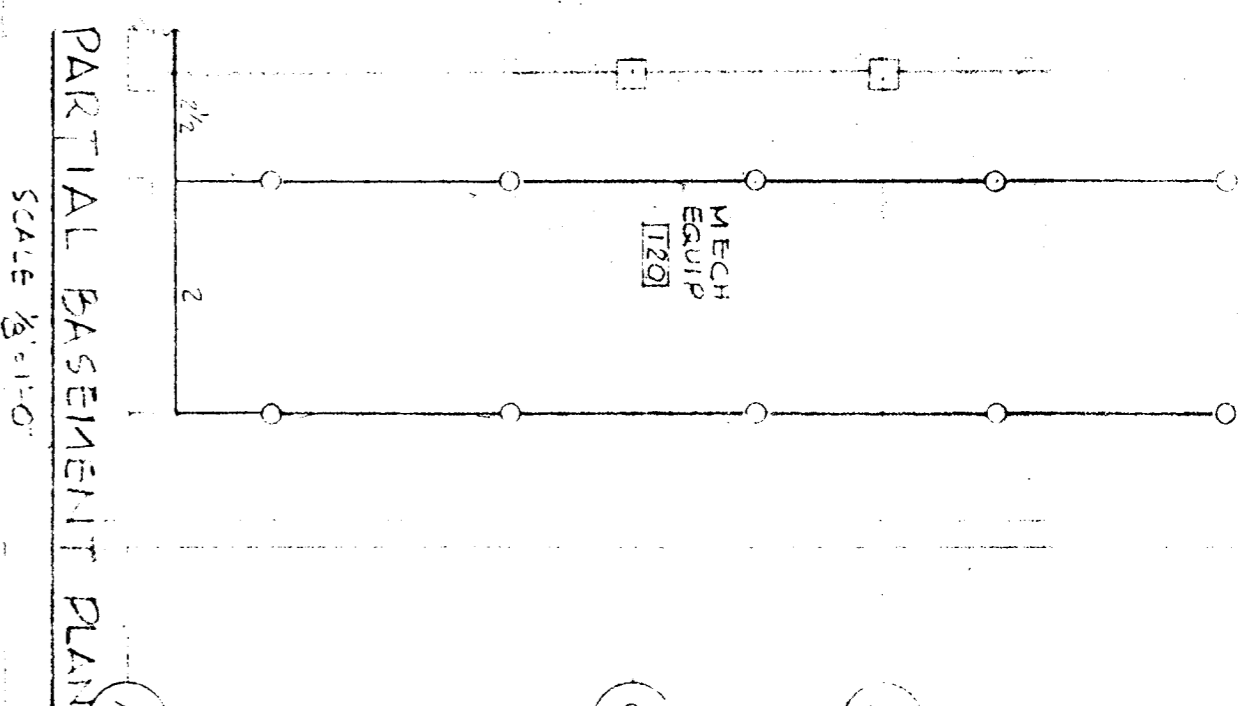

Scale 1/2" = 1'-0"

HENRY M. LAYNE
STRUCTURAL ENGINEER

SAMUEL L. KAYE
MECHANICAL ENGINEER


FOSTER K. SAMPSON
ELECTRICAL ENGINEER

5	1	2	3	4
---	---	---	---	---	---	---	---	---	---	----	----	-----	-----	---

R E V I S I O N S

SOUTH BAY HOSPITAL
SOUTH BAY HOSPITAL DISTRICT
REDONDO BEACH, CALIFORNIA

P-18

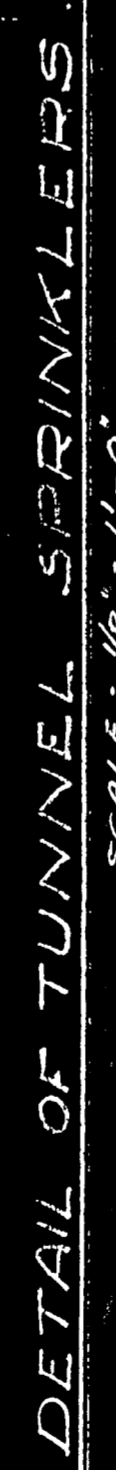

1-5-10 THE NATIONAL

